

WATER SERVICE RECORD

Name Courtney Comeau

Service No. 228

Address 32 Williams Road

3837

Location Lexington, Mass.

~~REPAIR~~ New Service


Cm. 11-13-51

Date	Material	Amount	Total	Date	Amount
9/29/51	Labor	1 49	1 49	9-19-51	25 00
	10% overhead		15	11-13-51	2 31
	50' -3/4" copper tubing@ .326	16 30	16 30		<u>NON CHARGE</u>
	1 -3/4" Cx 1/2 I.W.R. stop&waste	4 00	4 00	9/29/51	Labor 10 04
	1 hr. trucking		75		10' -3/4" copper tubing@.326 3 26
			22 69		1 -3/4" C. corp-cock 4 33
					1 -3/4" Cx3/4" C.curb-cock 4 67
					1 box and rod 4 68
					1 -1/2 offset tail piece 50
					1 -1/2 straight tail piece 50
					1 hr. trucking 75
					28 73

DATE _____

TOWN OF LEXINGTON — BOARD OF PUBLIC WORKS
WATER DIVISION

Sketch of Service Here

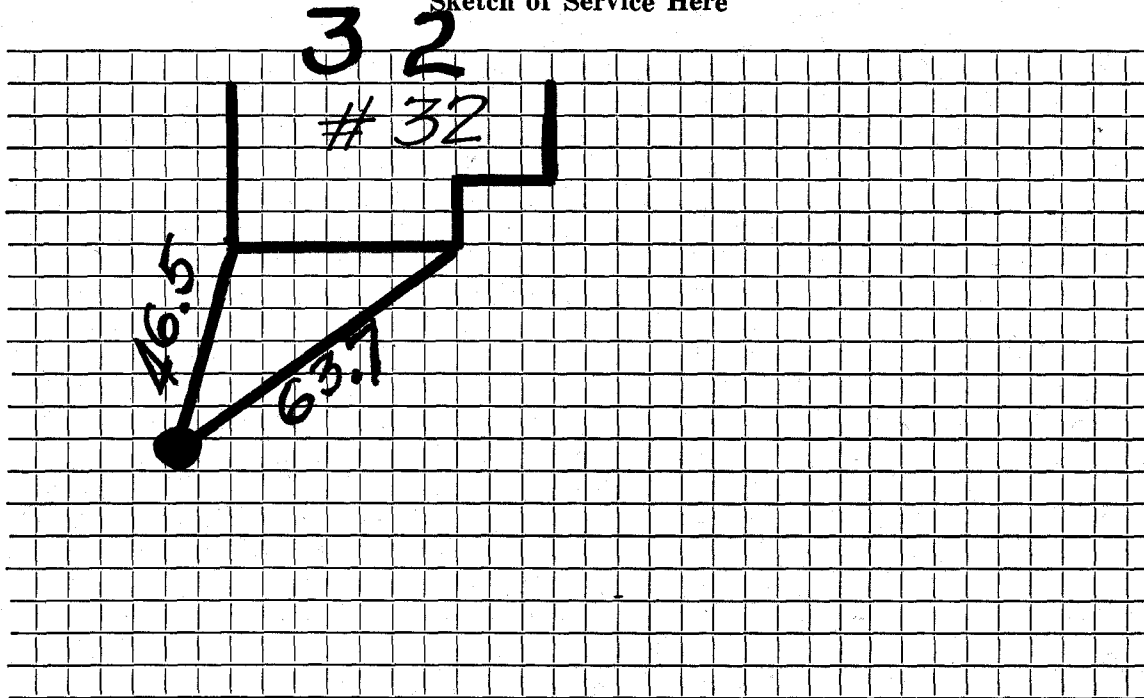

Connection made in Street. Work completed

Remarks:

.....

.....