

WATER SERVICE RECORD

Name

Service No.

Address 38 Williams Road

Location

~~REPAIR WORK~~ - New Service

SERVICE TO CURB:


Date		Material	Amount	Total	Date	Amount
7-13-	54					
	55	3/4" Copper				
		1 3/4" C. X 1/2" l.w.h.	STop + Waste			
						<u>NON CHARGE</u>
					7/14/53	Labor 1 90
					15'	- 3/4" copper tubing@.3629 5 44
					1	-3/4"C. corp-cock 4 33
					1	- 3/4" C x 3/4"C. curb-cock 4 67
					1	box and rod 3 90
					1	hr. trucking 75
						<u>20 99</u>

DATE \_\_\_\_\_

TOWN OF LEXINGTON — BOARD OF PUBLIC WORKS

WATER DIVISION

Sketch of Service Here

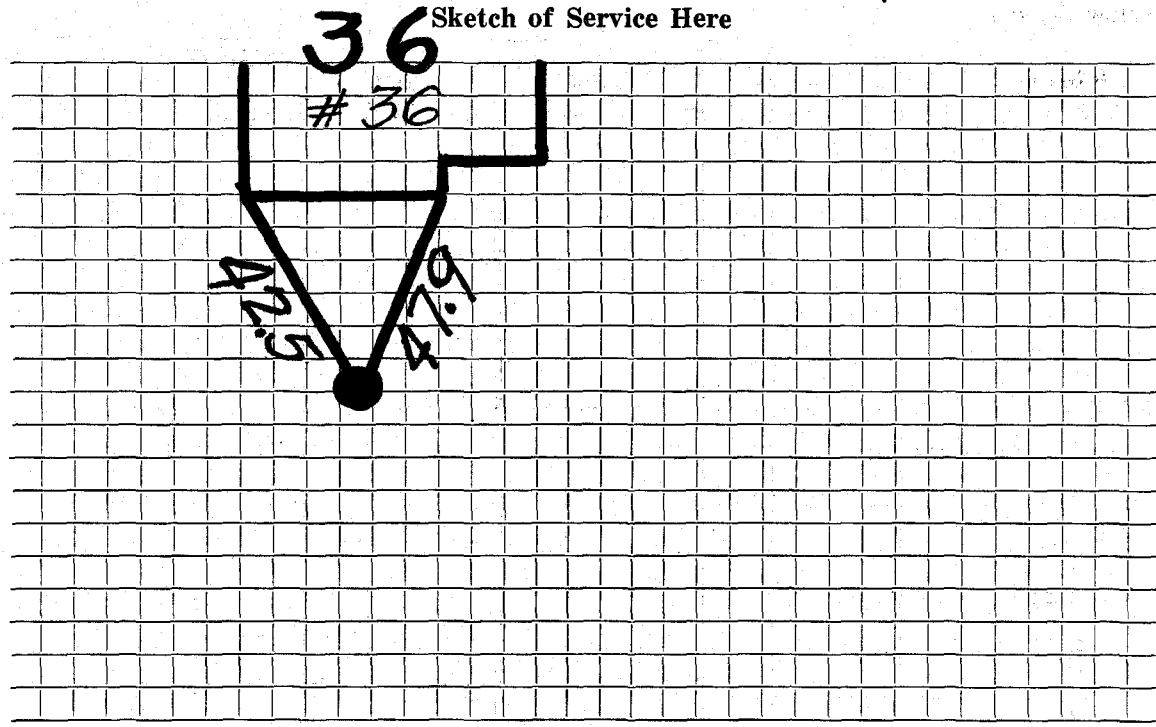

Connection made in ..... Street. Work completed .....

Remarks: .....

.....

.....