

WATER SERVICE RECORD

Name James McKay

Service No. 140

Address 40 Williams Road

Location Lexington

~~Repair~~ - New Service

Com. 9-22-52

Date	Material	Amount	Total	Date	Amount
8/19/52	Labor	1 63		5-11-52	Deposited 25 -
	10% overhead	16	1 79	9-24-52	Paid (2 17
	60' - 3/4" copper tubing@.3439	3439	20 63		<u>NON CHARGE</u> 27 17
	1 - 3/4" C x 1/2 I.W.H. stop & waste	4 00	4 00	8/19/52	Labor 1 63
	1 hr. trucking		75		18' - 3/4" copper tubing@.3439 6 19
			27 17		1 - 3/4" C. corp-cock 4 33
					1 - 3/4" C x 3/4" C. curb-cock 4 67
					1 - box and rod 3 90
					1 - 1/2 offset tail piece 50
					1 - 1/2 straight tail piece 50
					1 hr. trucking 75
					<u>22 47</u>


bill sent 9-24-52

DATE _____

TOWN OF LEXINGTON — BOARD OF PUBLIC WORKS

WATER DIVISION

Sketch of Service Here

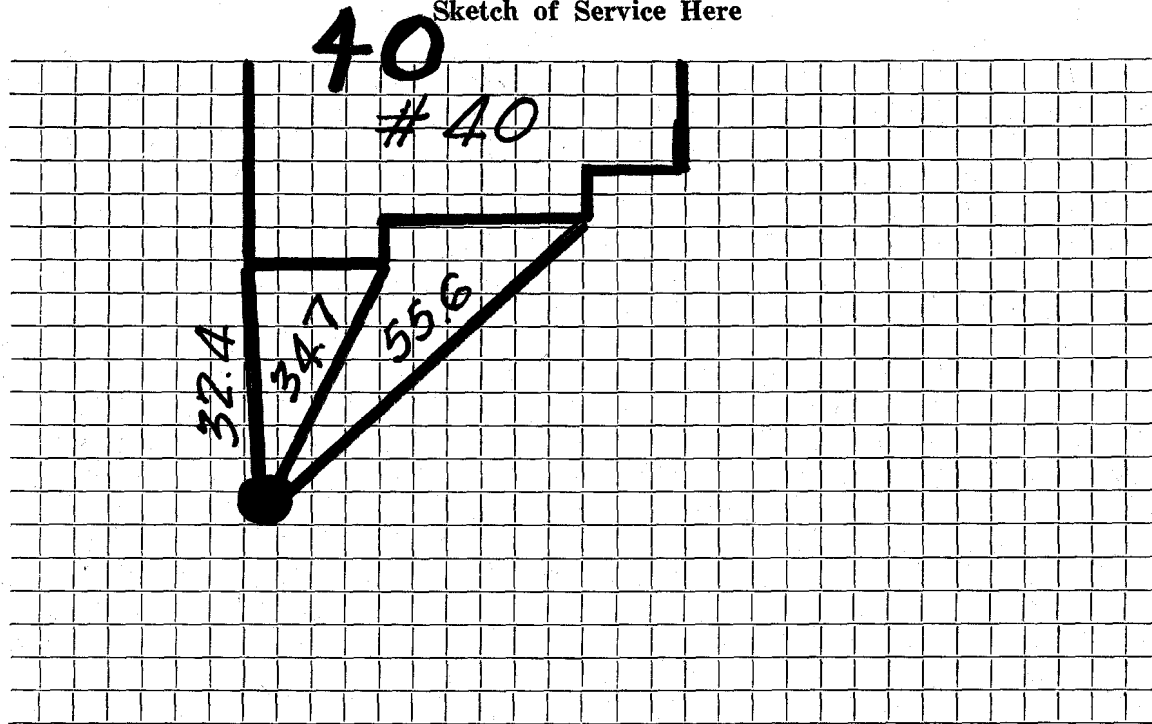

Connection made in Street. Work completed

Remarks:

.....

.....