

#6093

WATER SERVICE RECORD

Name C. C. Comeau

Service No. 49

Address 41 Williams Road

Location Lexington

Repair/Removal - New Service

Com. 6-16-52


Date	Material	Amount	Total	Date	Amount
4/29/52	Labor	1 63		4-11-52 Deposited	25 00
	10% overhead	16	1 79	6-16-52 <i>Refunded</i>	(4 71)
	40' - 3/4" copper tubing @ .3439-13	75			<u>NON CHARGE</u> 20 29
	1 - 3/4" C x 1/2 I.W.H. stop & waste	4 00		4/29/52 Labor	4 41
	1 hr. trucking		75	36' - 3/4" copper tubing @ .3439	12 38
			20 29	1 - 3/4" c. corp-cock	4 33
				1 - 3/4" C x 3/4" C. curb-cock	4 67
				1 - 3/4" C x 3/4" C. union	1 72
				1 box and rod	4 52
				1 - 1/2 offset tail piece	50
				1 - 1/2 straight tail piece	.50
				1 hr. trucking	75
					<u>33 78</u>

DATE _____

TOWN OF LEXINGTON — BOARD OF PUBLIC WORKS

WATER DIVISION

Sketch of Service Here

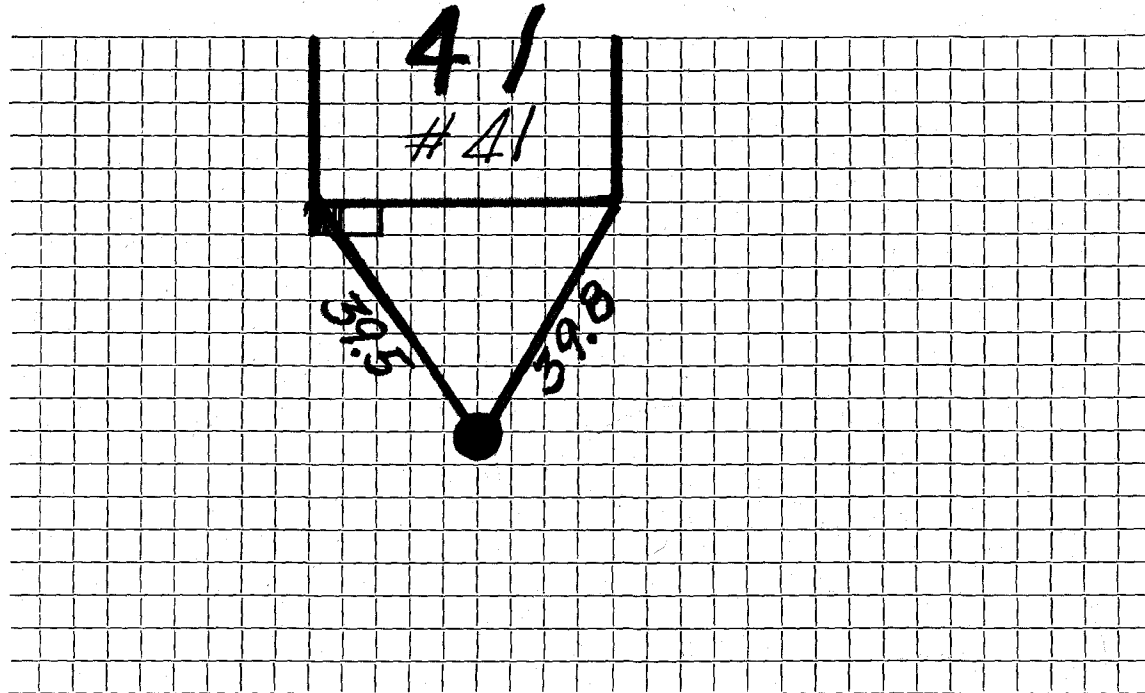

Connection made in Street. Work completed

Remarks:

.....

.....