

WATER SERVICE RECORD

Name

Service No.

Address 44 Williams Road

Location

~~REPLACEMENT~~ New Service

SERVICE TO CURB.

Date	Material	Amount	Total	Date	Amount
2-9-54	65' 3/4" Copper				
	1 3/4"C. X 1/2" I.W.H. Stop + Waste				
	1 3/4"C. X 3/4"C. Union				
				7/14/53 Labor	1 90
				15' - 3/4" copper tubing @ .3629	5 44
				1 - 3/4"C. corp-cock	4 33
				1 - 3/4"C x 3/4"C. curb-cock	4 67
				1 box and rod	3 90
				1 hr. trucking	75
					<u>20 99</u>


NON CHARGE

DATE _____

TOWN OF LEXINGTON — BOARD OF PUBLIC WORKS

WATER DIVISION

Sketch of Service Here

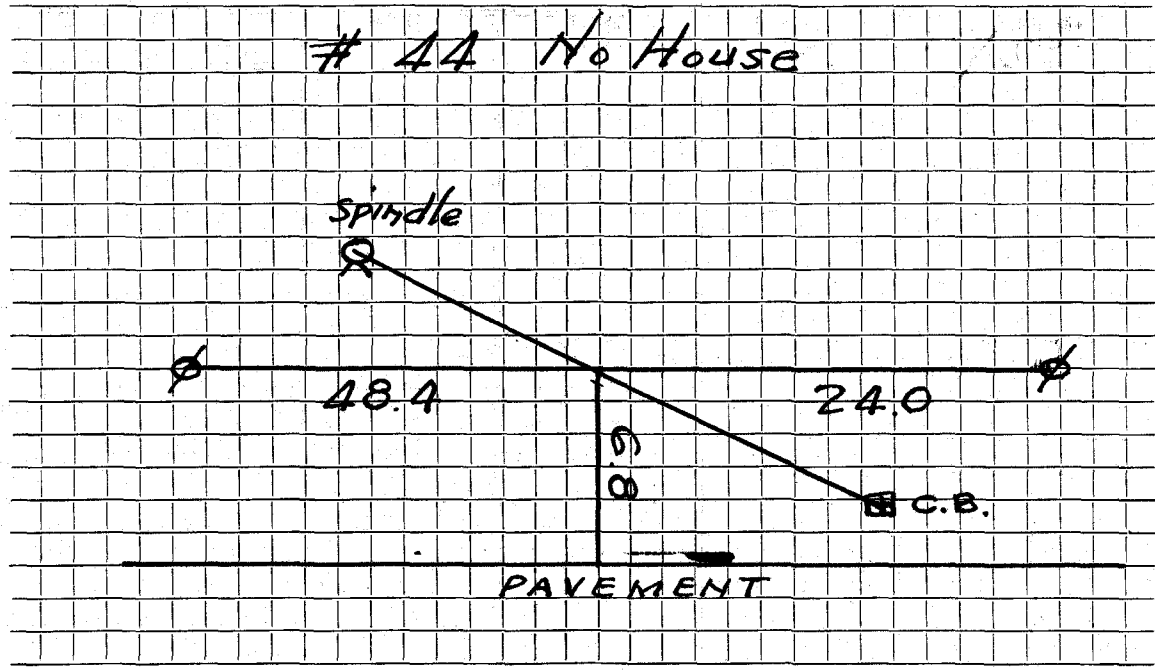

Connection made in Street. Work completed

Remarks:
.....
.....