

Name Leonard Devanna

Service No. 287 #4240

Address 49 Williams Road

Lexington, Mass.

Locatic 49 Williams Road

Kind of Pipe

Size

Size of Main

~~REPAIR WORK~~—New Service

Com 11-6-50

Location

| Date | Material | Amount | Total | Date | Location | Amount |
|--------------|--------------------------------|--------|-------|--------------|--------------------------------|--------|
| Sept. 9, '50 | Labor | 1 30 | 1 30 | Aug 31 '50 | Deposited | 20 00 |
| | 10% Overhead | | 13 | | | 1 |
| | 45' - 3/4" Copper Tubing @.275 | | 12 38 | | No Charge | 18 32 |
| | 1 - 3/4"C x 1/2" I.W.H. S&W | | 3 76 | Sept. 9, '50 | Labor | 1 30 |
| | Trucking 1 hr. @.75 | | 75 | | 18' - 3/4" Copper Tubing @.275 | 4 95 |
| | | | 18 32 | | 1 - 3/4"C Corp-cock | 3 60 |
| | | | | | 1 - 3/4"C x 3/4"C Curb-cock | 4 40 |
| | | | | | 1 - Box & Rod | 3 35 |
| | | | | | Trucking 1 hr. @.75 | 75 |
| | | | | | 1-1/2" Offset Tail Piece | 42 |
| | | | | | 1 - 1/2" Straight Tail Piece | 42 |
| | | | | | | 19 19 |
| | Labor | | | | | |

DATE _____

TOWN OF LEXINGTON—BOARD OF PUBLIC WORKS

WATER DIVISION

The undersigned applies for a supply of water at No. _____ St. and hereby agrees to comply with the rules and regulations as now, or at any future time, established by the Board of Selectmen.

Am't. of Estimate \$ _____


Owner _____

Am't. Paid \$ _____

Address _____

Builder _____

Sketch of Service Here

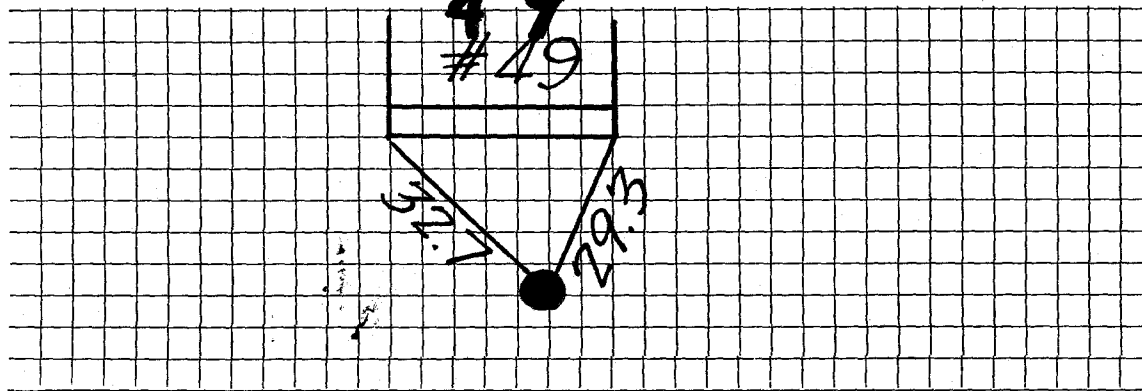

Connection made in _____ Street.

Work completed _____ 19

Remarks: