

WATER SERVICE RECORD

Name James A. MacKay

Service No. 268

Address 50 Williams Road

2844

Location Lexington


Route ~~CR 2000~~ - New Service

Com. 11-24-52

Date	Material	Amount	Total	Date	Amount
10/9/52	Labor	1 63		10-9-52	Deposited 25 00
	10% overhead	16	1 79	11-24-52	Refunded () 78
	52' - 3/4" copper tubing@.34		17 68		<u>NON CHARGE</u> 24 22
	1 -3/4" C. x 1/2 I.W.H. stop& waste		4 00	10/9/52	Labor
	1 hr. trucking		75		5' - 3/4" copper tubing@.34
			24 22		1 -3/4" C.corb-cock
					1 -3/4" C x 3/4" C.curb-cock
					1 box and rod
					1 -1/2 straight tail piece
					1 -1/2 offset tail piece
					1 hr. trucking
					<u>75</u>
					17 98

TOWN OF LEXINGTON — BOARD OF PUBLIC WORKS
WATER DIVISION

Sketch of Service Here

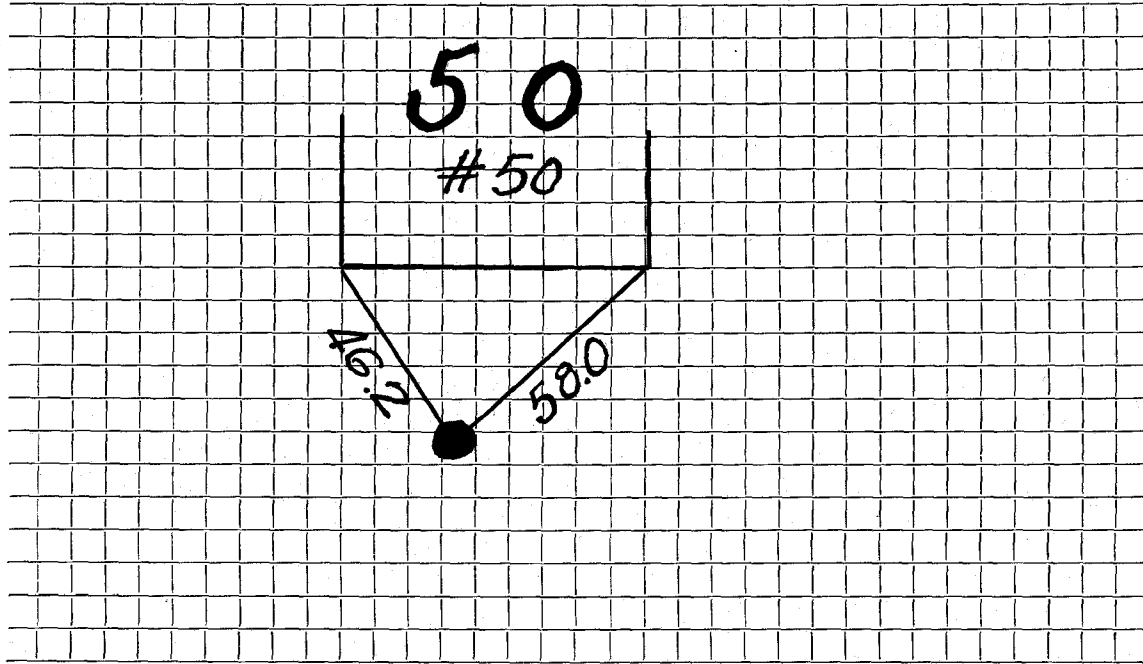

Connection made in Street. Work completed

Remarks:

.....

.....