

WATER SERVICE RECORD

Name

Service No.

Address 51 Williams Road

Location

~~REPAIRS~~—New Service

SERVICE TO CURB ONLY


Date	Material	Amount	Total	Date	Amount
12-9-53	48' 3/4" Copper				
	1 3/4" C. X 1/2" I.W.H. Stop + Waste				
					<u>NON CHARGE</u>
				5/25/53 Labor	1 75
				23' - 3/4" copper tubing@.37	8 51
				1 - 3/4" C. corp-cock	4 33
				1 - 3/4" C x 3/4" C. curb-cock	4 67
				1 box and rod	3 90
				1 hr. trucking	75
					<u>23 91</u>

DATE _____

TOWN OF LEXINGTON — BOARD OF PUBLIC WORKS

WATER DIVISION

Sketch of Service Here

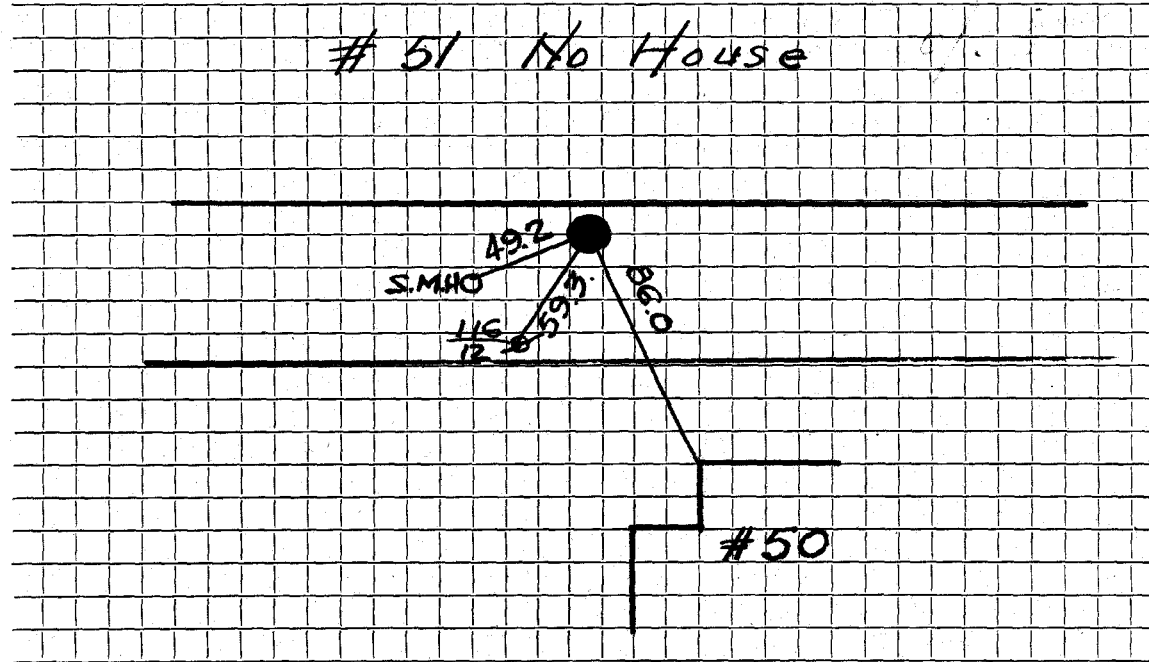

Connection made in Street. Work completed

Remarks:

.....

.....