

WATER SERVICE RECORD

3625

Name C. Courtney Comeau

Service No. 77

Address 53 Williams Rd.

Location Lexington

~~WATER SERVICE~~ New Service

COM. 6-8-53

Date	Material	Amount	Total	Date	Amount
5/13/53	Labor	1 75		4-21-53	Deposited 25 00
	10% overhead	18	1 93	6-8-53	* Refunded (3 02)
	1/5" - 3/4" Copper Tubing @ .31		15 30		NON CHARGE 21 98
	1-3/4" C x 1/2" I.W.H. STOP & WASTE		4 00	5/13/53	Labor 1 75
	1 Hr. Trucking		75	26' - 3/4" Copper Tubing @ .34	8 84
			21 98	1-3/4" C. Corp-cock	4 33
				1-3/4" C x 3/4" C. Curb-cock	4 67
				1-Box & Rod	3 90
				1-1/2" straight tail piece	50
				1-1/2" offset tail piece	50
				1 Hr. Trucking	75
					25 24


* this refund made payable to town of Lex. To apply on bal. due on sewer conn #68

DATE _____

TOWN OF LEXINGTON — BOARD OF PUBLIC WORKS

WATER DIVISION

Sketch of Service Here

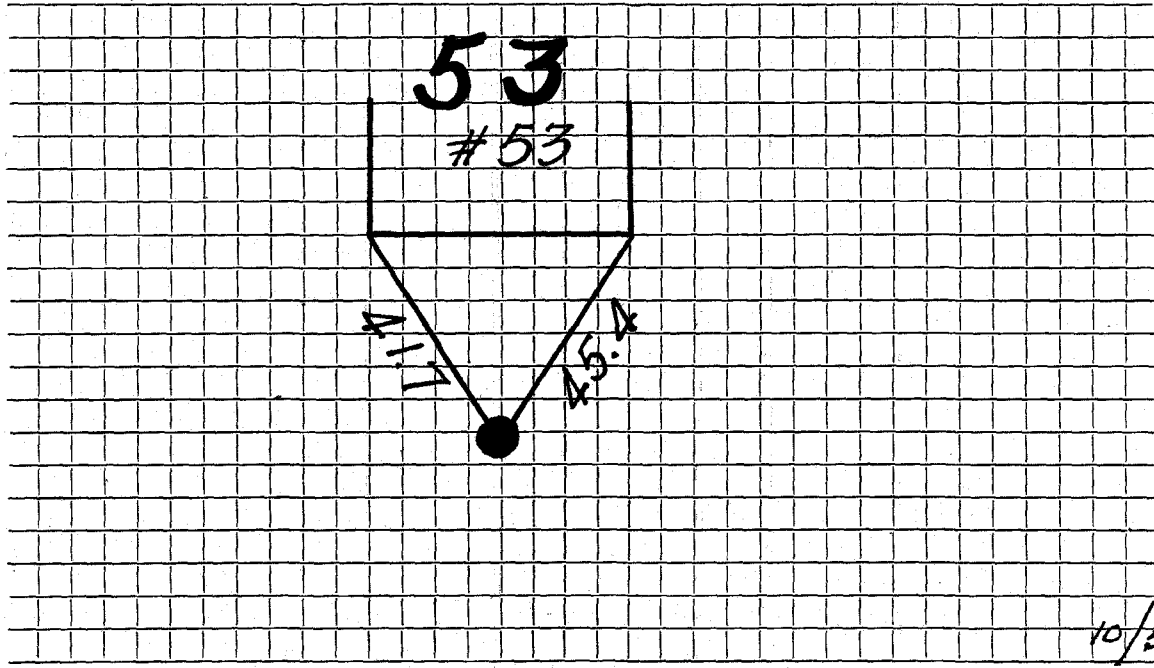

10/53

Connection made in Street. Work completed

Remarks:

.....

.....