

WATER SERVICE RECORD

#5123

Name C. Courtney Comeau

Service No. 76

Address 55 Williams Rd.

Location Lexington

~~Water~~ New Service

COM. 6-8-53

Date	Material	Amount	Total	Date	Amount
5/12/53	Labor	1 75		4-17-53 Deposited	25 00
	10% overhead	18	1 93	6-8-53 *Refunded	2 00
	48' - 3/4" Copper Tubing @.34		16 32		NON CHARGE 2 3 00
	1-3/4" C x 1/2 I.W.H. stop & waste		4 00	5/12/53 Labor	1 75
	1 Hr. Trucking		75	23' - 3/4" Copper Tubing @.34	7 82
			23 00	1-3/4" C. Corp-cock	4 33
				1-3/4" C x 3/4" C. Curb-cock	4 67
				1-Box & Rod	3 90
				1-1/2 offset tail piece	50
				1-1/2 straight tail piece	50
				1 Hr. Trucking	85
					24 22


* This refund made payable to Town of Lex by order of 6/1 due on sewer accn. #68

DATE _____

TOWN OF LEXINGTON — BOARD OF PUBLIC WORKS

WATER DIVISION

Sketch of Service Here

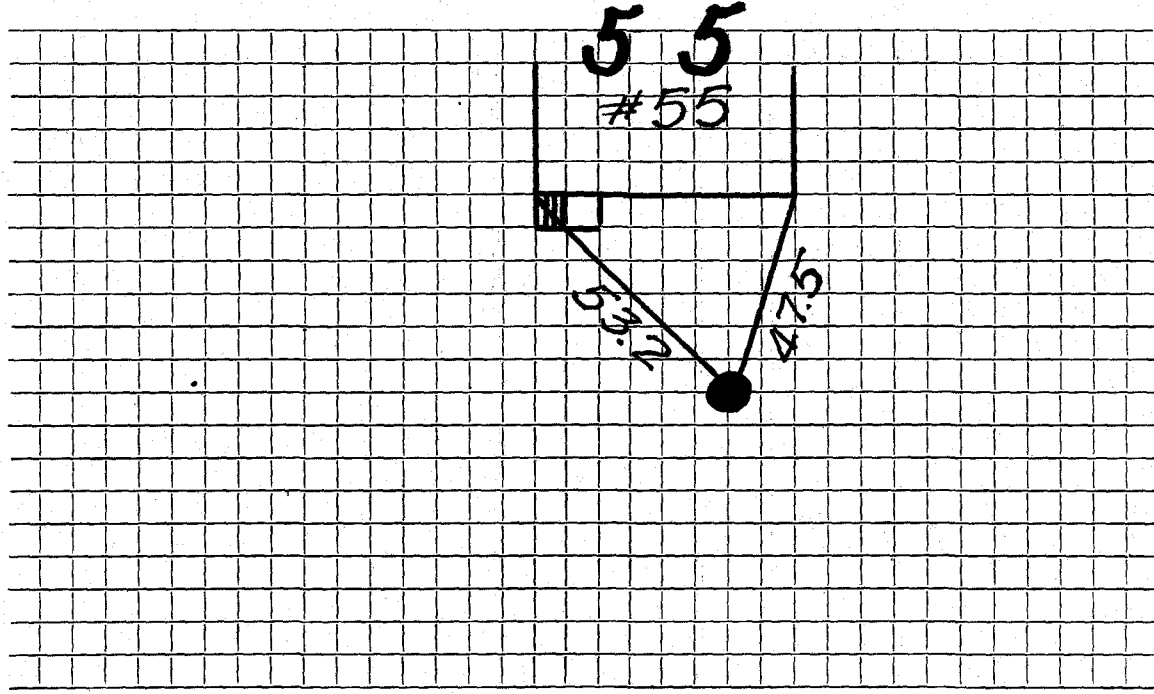

Connection made in Street. Work completed

Remarks:

.....

.....