


DATE _____

TOWN OF LEXINGTON — BOARD OF PUBLIC WORKS

WATER DIVISION

Sketch of Service Here

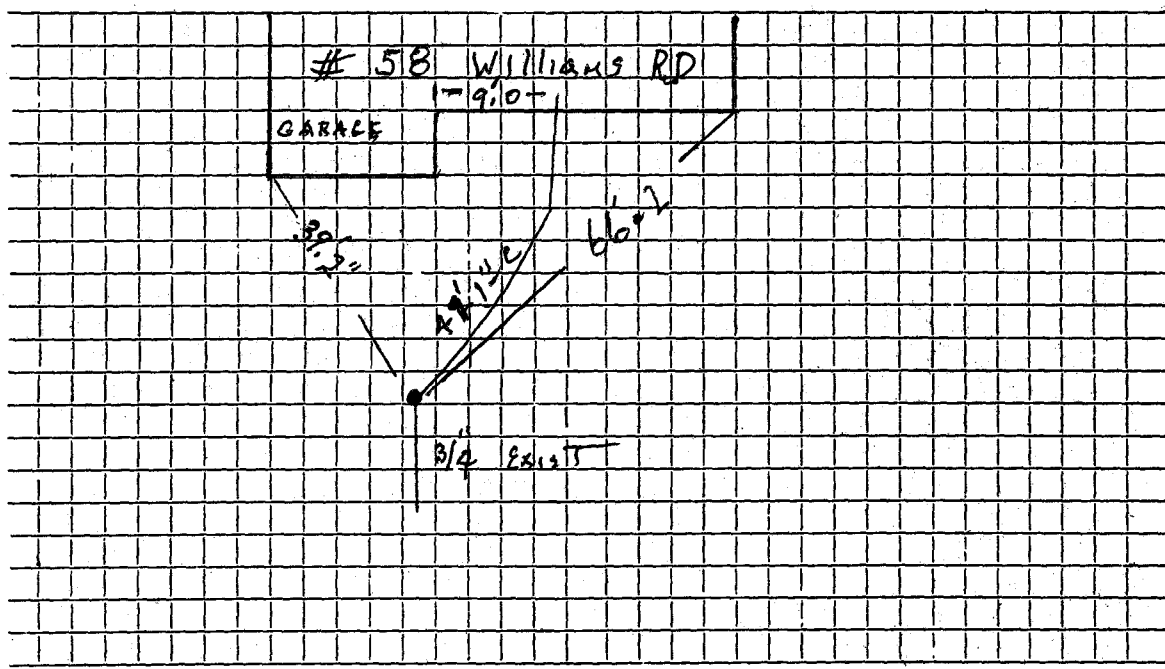

Connection made in Street.

Work completed 4/26/05 J. McLaughlin.....

Remarks:

.....

.....

WATER SERVICE RECORD

#5492

Name C. C. Comeau

Service No. 224

Address 58 Williams Road

Location Lexington

Repair ~~Record~~ - New Service


Com. 11-24-52

Date	Material	Amount	Total	Date	Amount
10/9/52	Labor	1 63		9-23-52	Deposited 25 -
	10% overhead	16	1 79	11-24-52	Refunded & credited () 78
	52' - 3/4" copper tubing @ .34		17 68		40 S.H.C. #149 NON CHARGE 24 22
	1 - 3/4" C x 3/8 I.W.H. stop & waste		4 00	10/9/52	Labor 1 63
	1 hr. trucking		75		
			24 22		
					9' - 3/4" copper tubing @ .34 3 06
					1 - 3/4" C. corp-cock 4 33
					1 - 3/4" Cx 3/4" C. curb-cock 4 67
					1 box and rod 3 90
					1 - 3/8 offset tail piece 50
					1 - 3/8 straight tail piece 50
					1 hr. trucking 75
					19 34

DATE _____

TOWN OF LEXINGTON — BOARD OF PUBLIC WORKS
WATER DIVISION

Sketch of Service Here

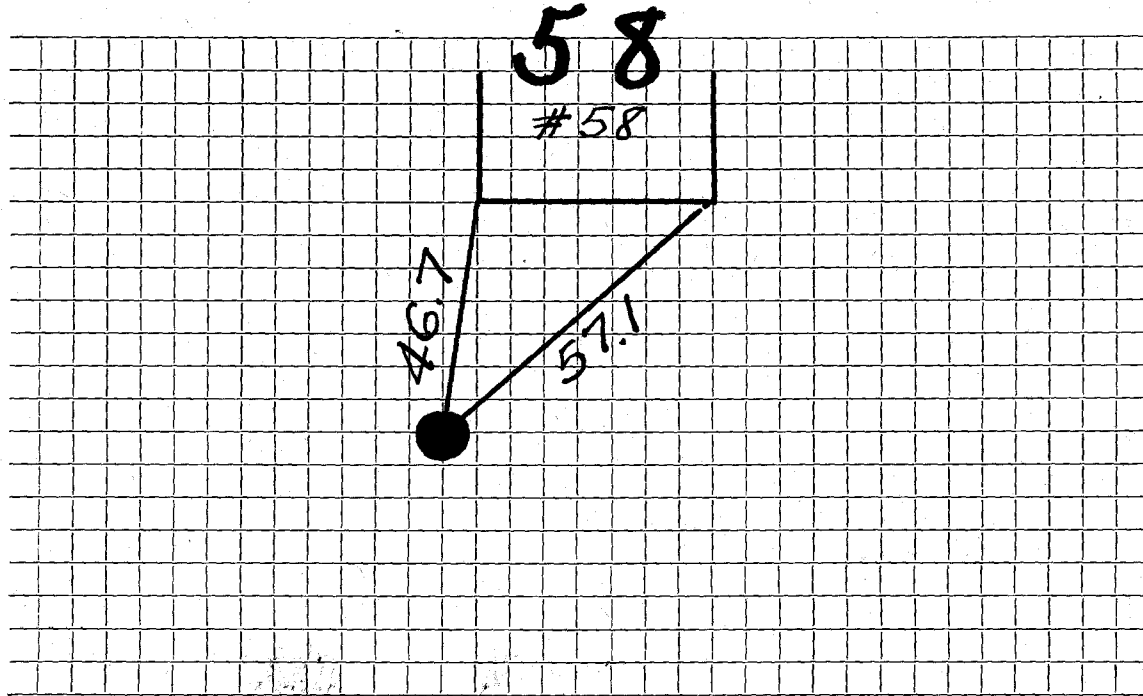

Connection made in Street. Work completed

Remarks:
.....
.....