

WATER SERVICE RECORD

Name

Service No.

Address 59 Williams Road

Location

~~Repair~~ ~~Renewal~~ New Service

SERVICE TO CURB ONLY:

Date	Material	Amount	Total	Date	Amount
3-22-54	65' 3/4" Copper				
	1 3/4" C. X 1/2" l.w.h. STop + Waste				
	1 3/4" C. X 3/4" Iron 3 Part Union				
				5/19/53 Labor	1 75
				24' - 3/4" copper tubing@.37	8 88
				1 - 3/4" C corp-cock	4 33
				1 - 3/4" C x 3/4" C curb-cock	4 67
				1 box and rod	3 90
				1 hr. trucking	75
					<u>24 28</u>


NON CHARGE

DATE \_\_\_\_\_

TOWN OF LEXINGTON — BOARD OF PUBLIC WORKS

WATER DIVISION

Sketch of Service Here

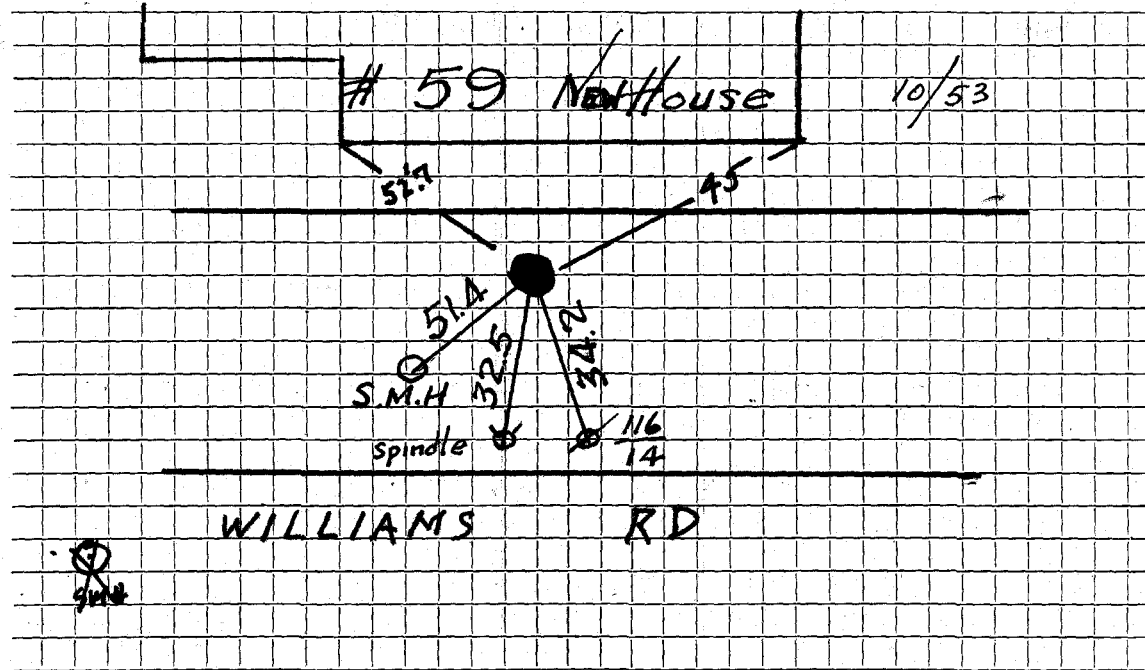

Connection made in ..... Street. Work completed .....

Remarks: New House - 10/98 .....

.....  
.....