


DATE _____

TOWN OF LEXINGTON — BOARD OF PUBLIC WORKS
WATER DIVISION

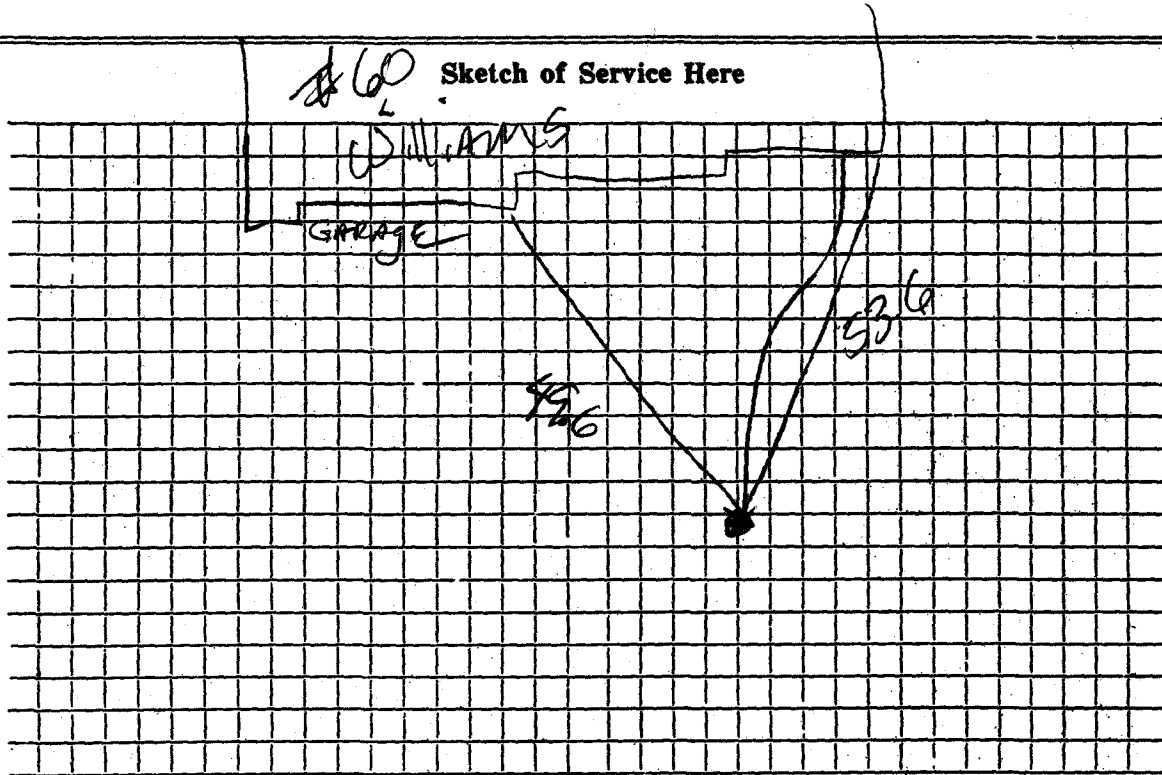

Connection made in Street. Work completed

Remarks:

.....

.....