

WATER SERVICE RECORD

Name

Service No.

Address

61 Williams Road

Location

~~XXXXXXXXXX~~ - New Service

SERVICE TO CURB ONLY


Date	Material	Amount	Total	Date	Amount
12-17-54	46' 3/4" Copper				
	1 3/4" C. x 1/2" I.W.H. Stop & Waste				
					<u>NON CHARGE</u>
				5/19/53 Labor	1 75
				27' - 3/4" copper tubing @ .37	9 99
				1 - 3/4" C. corp-cock	4 33
				1 - 3/4" C x 3/4" C. curb-cock	4 67
				1 box and rod	3 90
				1 hr. trucking	75
					<u>25 39</u>

DATE _____

TOWN OF LEXINGTON — BOARD OF PUBLIC WORKS

WATER DIVISION

Sketch of Service Here

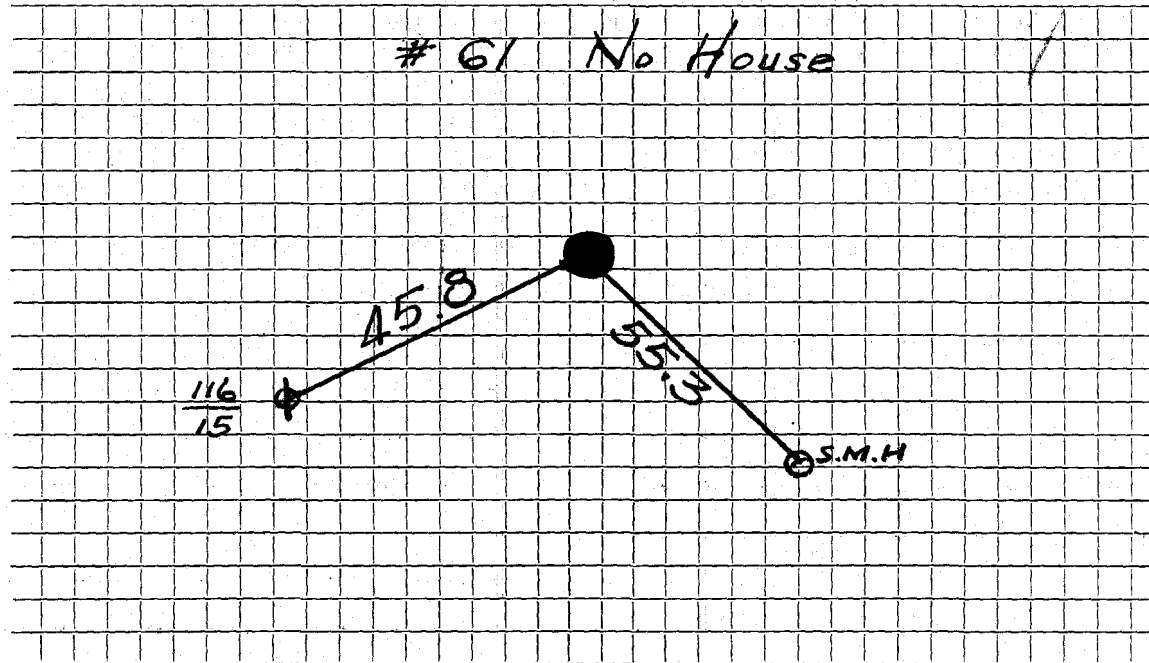

Connection made in Street. Work completed

Remarks:

.....

.....