

WATER SERVICE RECORD

Name

Service No.

Address 64 Williams Road

Location

~~REPAIR WORK~~ - New Service

SERVICE TO CURB ONLY:


Date	Material	Amount	Total	Date	Amount
6-1-54	45' 3/4" Copper				
	1 3/4" C. X 1/2" I.W.H. Stop + Waste				
					<u>NON CHARGE</u>
				5/20/53 Labor	1 75
				14' - 3/4" copper tubing @ .37	5 18
				1 - 3/4" C. corp-cock	4 33
				1 - 3/4" C x 3/4" C. curb-cock	4 67
				1 box and rod	3 90
				1 hr. trucking	75
					20 58

DATE _____

TOWN OF LEXINGTON — BOARD OF PUBLIC WORKS

WATER DIVISION

Sketch of Service Here

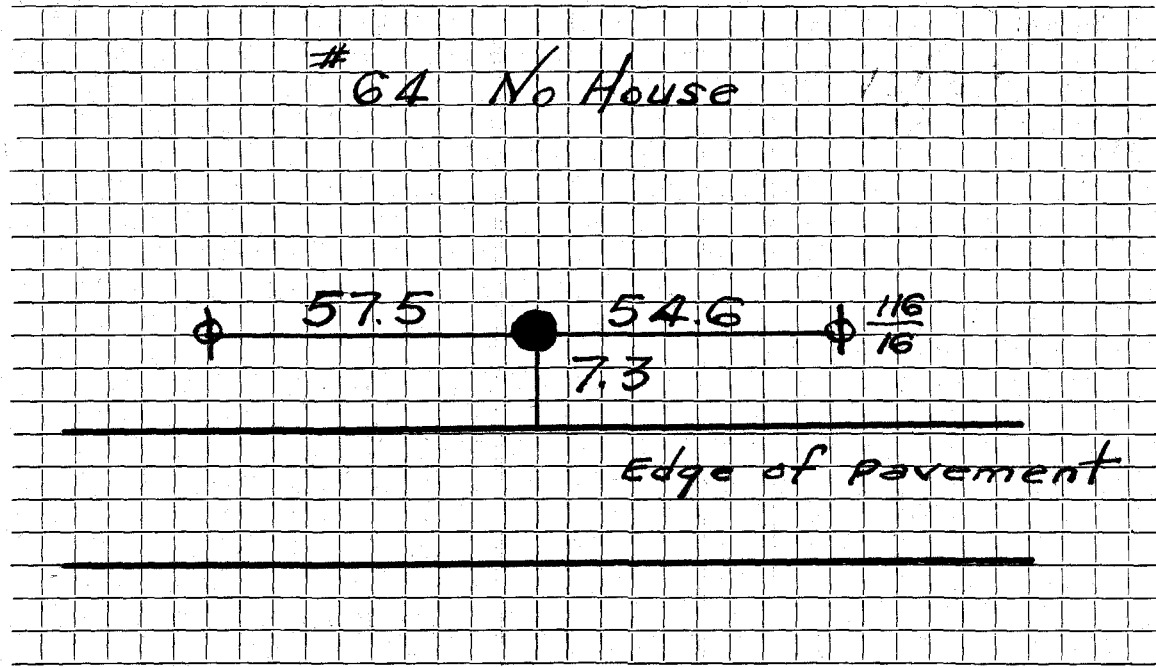

Connection made in Street. Work completed

Remarks:
.....
.....