

WATER SERVICE RECORD

Name Walter Ladow

Service No. 62

Address 65 Williams Rd.

2491

Location Lexington

~~REPAIR WORK~~ New Service COM. 6-8-53

Date	Material	Amount	Total	Date	Amount
4/21/53	Labor	1 75		3-25-53 Deposited	25 00
	10% overhead	18	1 93	6-8-53 Refunded	(1 32
	50'-3/4" Copper Tubing @.34		17 00		NON CHARGE 23 68
	1-3/4 C x 1/2 I.W.H. STOP & WASTE		4 00	4/21/53 Labor	1 75
	1 Hr. Trucking		75	30'-3/4" Copper Tubing @.34	10 20
			23 68	1-3/4" C. Corp-cock	4 33
				1-3/4" C x 3/4" C. Curb-cock	4 67
				1-Box & Rod	3 90
				1-1/2 straight tail piece	50
				1-1/2 offset tail piece	50
				1 Hr. Trucking	75
					26 60


DATE _____

TOWN OF LEXINGTON — BOARD OF PUBLIC WORKS

WATER DIVISION

65

Sketch of Service Here

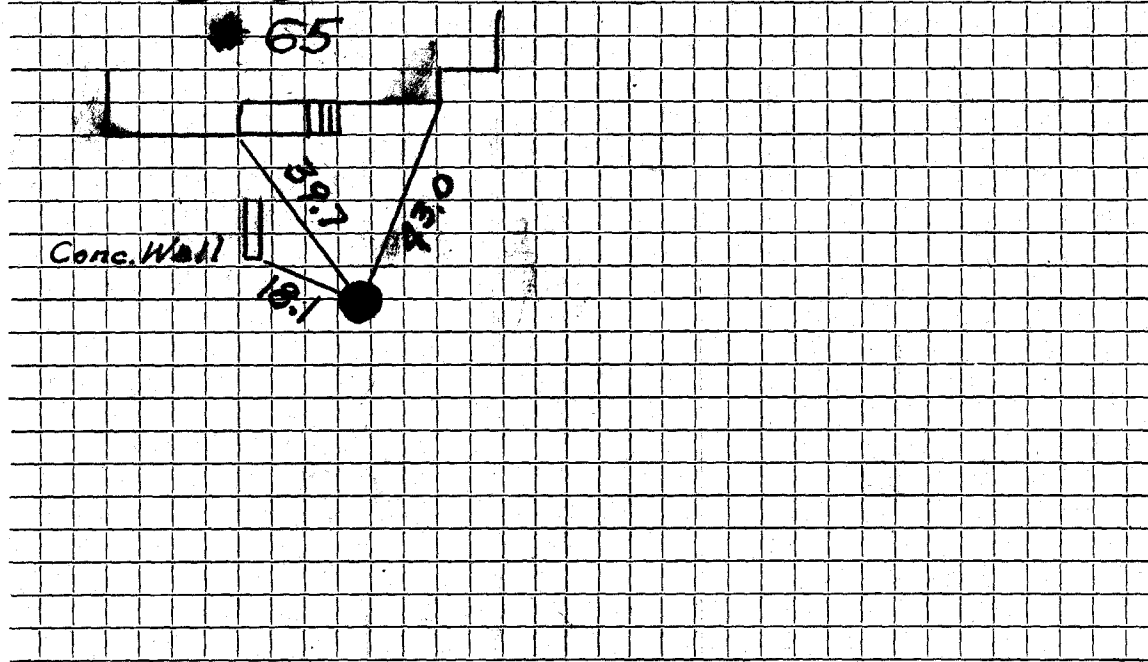

Connection made in Street. Work completed

Remarks:

.....

.....