

WATER SERVICE RECORD

Name

Service No.

Address

16 Willow Street


Location

Repair—Renewal—New Service

Date	Material	Amount	Total	Date	Amount
Mar 30, '46	88' 3/4" Copper				
	1 3/4" Curb				
	1 3/4" Union				
	1 3/4" x 1/2" Stop & Waste				
6-6-96	100' 1" Copper			6-6-96	OUTSIDE
	10' 3/4" Copper				
	1 1" x 3/4" Union			25'	1" Copper
	1 3/4" Union			1	1" Curb
				1	1" Corp
				1	Buffalo Box

TOWN OF LEXINGTON — BOARD OF PUBLIC WORKS

WATER DIVISION

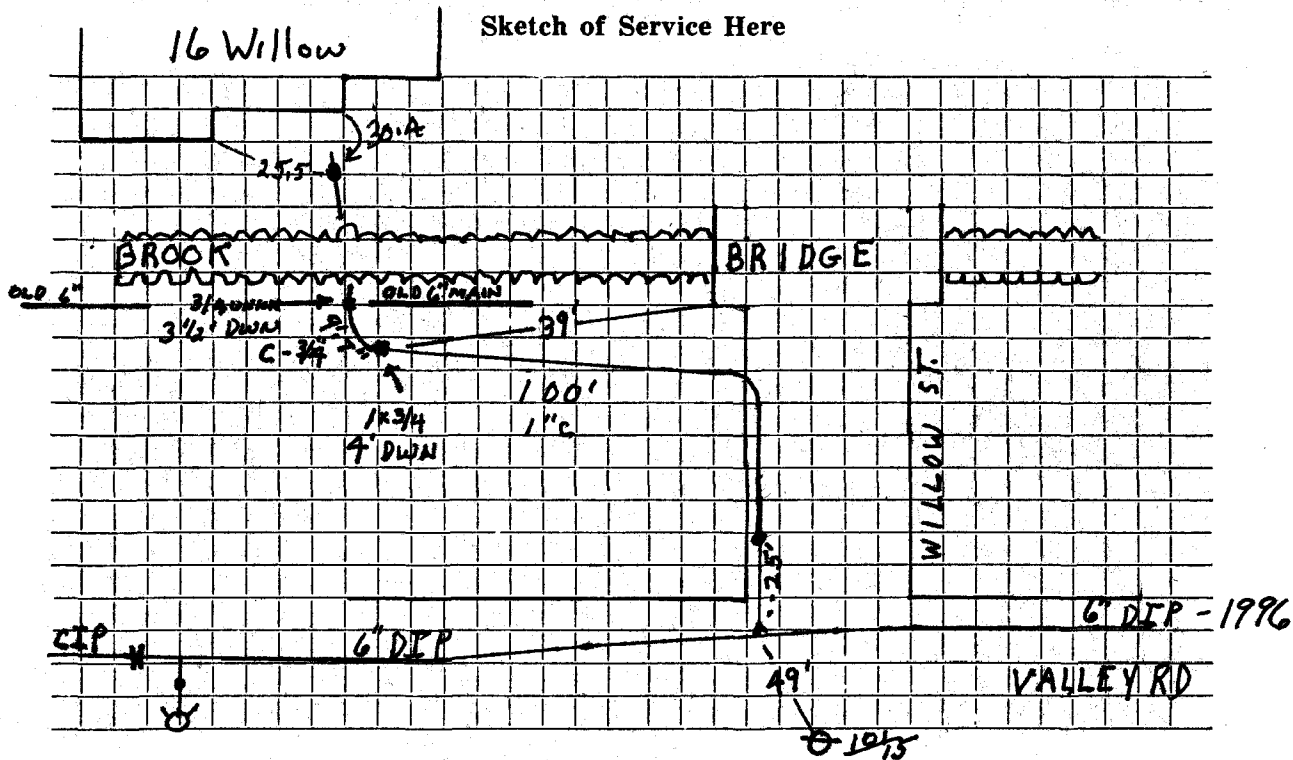

Connection made in Street. Work completed
10/13

Remarks:
.....
.....