


DATE 1/17/2020

TOWN OF LEXINGTON — BOARD OF PUBLIC WORKS

WATER DIVISION

Sketch of Service Here

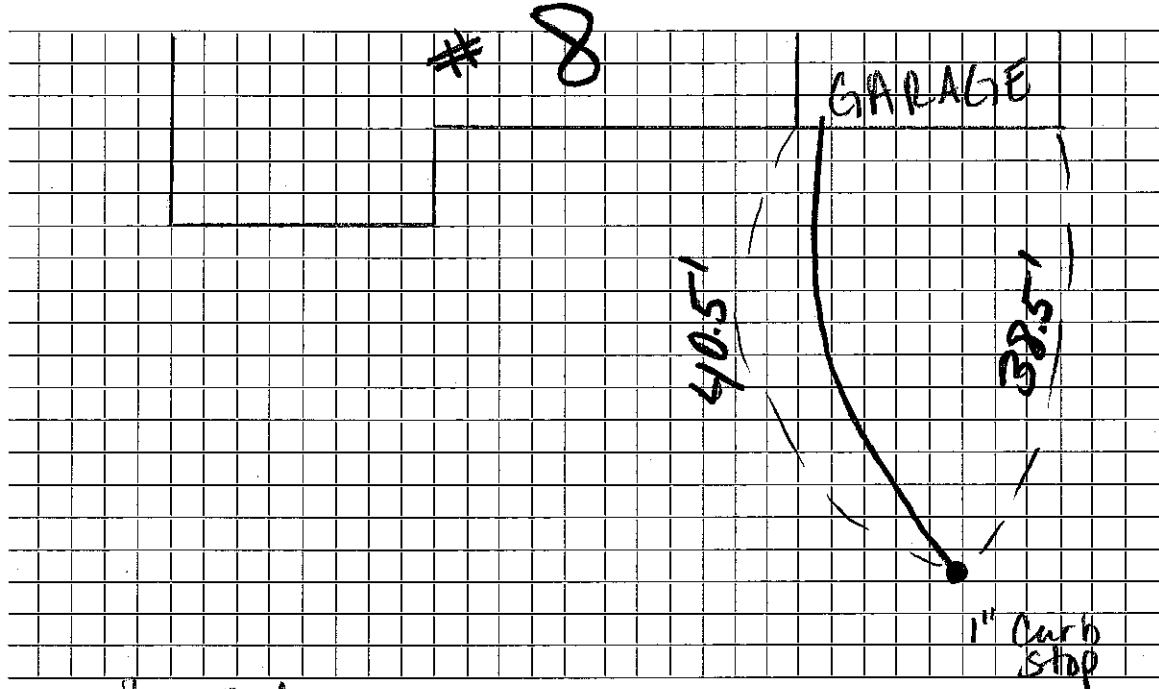

Connection made in ... Wilson Rd Street. Work completed

Remarks:
..... Will be a porch 5' out front of home
.....