

Name Robert L. Innis

Service No. 151

Address 12 Wilson Road

3085

Lexington, Mass.

Location 12 Wilson Road

Kind of Pipe

Size

Size of Main

~~Repair - Renewal~~ - New Service

Location

Date	Material	Amount	Total	Date	Location	Amount
Aug. 19, '48	Labor	2 00	2 00	Aug 12 '48	Deposited	35 00
21	Labor	1 15	1 15	Aug 25 '48	Returned	6 11
	10% Overhead		32		Non Charge	28 89
	40'-3/4" Copper Tubing		10 20	Aug. 21, '48	Labor	2 00
	1-3/4" C x 1/2" I.W.H. S & W		3 15		10'-3/4" Copper Tubing	2 55
	1-3/4" C x 3/4" C. Union (3 pts.)		1 32		1-3/4" C. Corp. Cock	3 00
	1 hr. Littlefield Shovel		7 00		1-3/4" C x 3/4" C. Curb Cock	3 68
	1 hr. Allis Chalmers		3 00		1-1/2" Offset Tail Piece	30
	1 hr. Trucking		75		1-1/2" Straight Tail Piece	30
			28 89		1 hr. Trucking	75
						12 58

Am. 10/25/CP

Labor

Hadley Press, Inc., Lexington

DATE \_\_\_\_\_

# TOWN OF LEXINGTON—BOARD OF PUBLIC WORKS

## WATER DIVISION

The undersigned applies for a supply of water at No. \_\_\_\_\_ St. and hereby agrees to comply with the rules and regulations as now, or at any future time, established by the Board of Selectmen.

Am't. of Estimate \$ \_\_\_\_\_


Owner \_\_\_\_\_

Am't. Paid \$ \_\_\_\_\_

Address \_\_\_\_\_

Builder \_\_\_\_\_

Sketch of Service Here

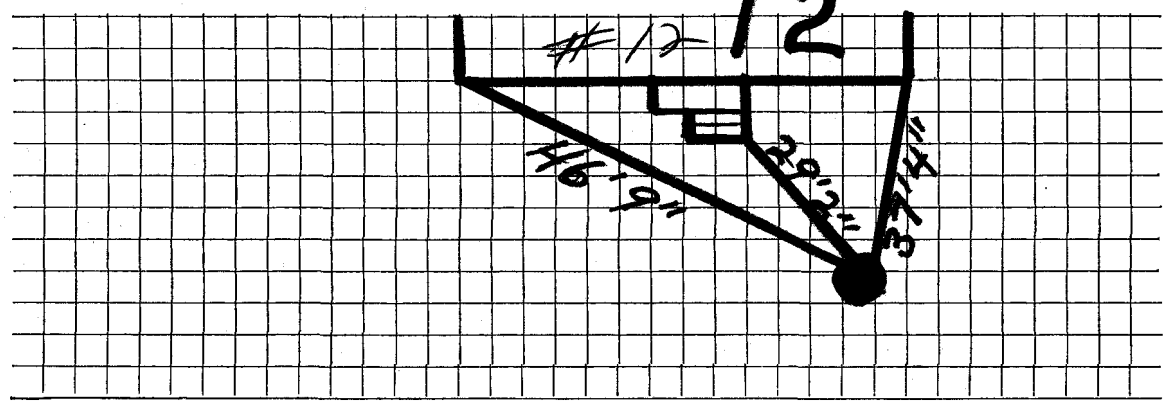

Connection made in \_\_\_\_\_ Street.

Work completed \_\_\_\_\_ 19

Remarks: