

Name **Walter D. Crosby**Service No. **88****2783**Address **15 Wilson Road****Lexington, Mass.**Location **15 Wilson Road**

Kind of Pipe

Size

Size of Main

~~XXXXXXXXXX~~ **New Service**Com. **5-29-50**

Location

Date	Material	Amount	Total	Date	Amount
May 13, '50	Labor	2 86	2 86	May 11 '50	50 00
	10% Overhead		29	July 8 '50	17 53
	43' - 3/4" Copper Tubing @.23		9 89		32 47
	1 - 3/4" C x 1/2" I.W.H. S&W		3 29	May 13, '50	2 86
	1 - 3/4" C x 3/4" C Union (3pts)		1 39	23' - 3/4" Copper Tubing @.23	5 29
	Littlefield Shovel 2 hrs. @ 7.00	14 00		1 - 3/4" C orpc-cock	3 15
	Trucking 1 hr. @.75		75	1 - 3/4" C x 3/4" C Curb-cock	3 85
			32 47	1 - Box & Rod	3 60
				1 - 1/2" Offset Tail Piece	38
				1 - 1/2" Straight Tail Piece	38
				Littlefield Shovel 1 hr. @ 7.00	7 00
				Trucking 1 hr. @.75	75
	Labor				27 26

DATE _____

TOWN OF LEXINGTON – BOARD OF PUBLIC WORKS

WATER DIVISION

The undersigned applies for a supply of water at No..... St. and hereby agrees to comply with the rules and regulations as now, or at any future time, established by the Board of Selectmen.

Am't of Estimate \$.....


Owner

Am't Paid \$.....

Address

Builder

.....

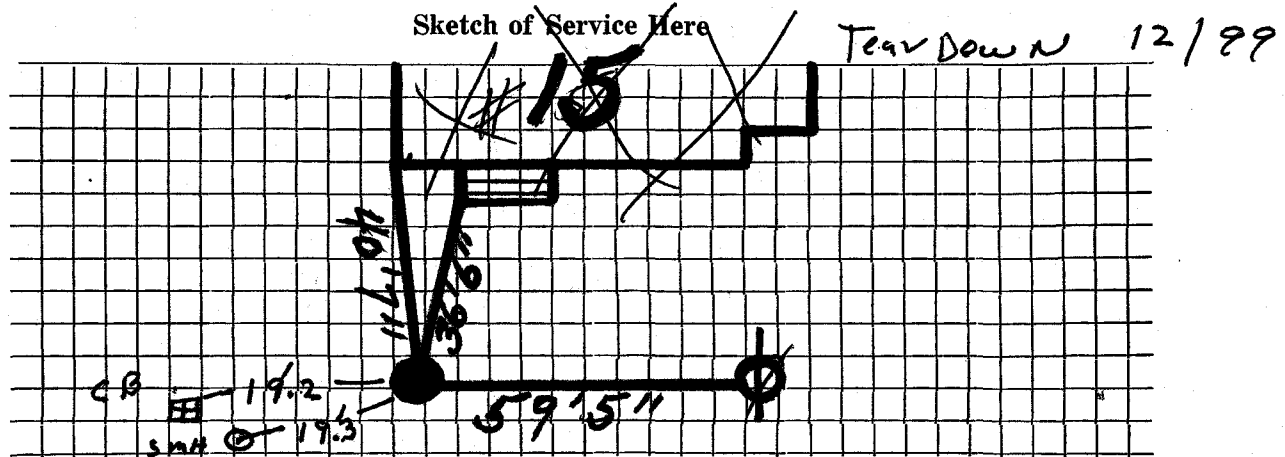

Connection made in Street.

Work completed19

Remarks: