

Name Robert L. Innis

Service No.

160
#5467

Address 18 Wilson Road

Lexington, Mass.

Location 18 Wilson Road

553

Kind of Pipe

Size

Size of Main

~~BOILER WORK~~ — New Service

Location

Date	Material	Amount	Total	Date	Amount
Aug. 19, '48	Labor	2 00	2 00	Aug 19 '48	25 00
20	Labor	1 15	1 15		
	10% Overhead		32		
	37'-3/4" Copper Tubing		9 44	Sept. 20, '48 Labor	1,82
	1-3/4" C x 1/2" I.W.H. S & W		3 15	9'-3/4" Copper Tubing	2 30
	1 hr. Littlefield Shovel		7 00	1-3/4" C. Corp Cock	3 00
	1 hr. Allis Chalmers Shovel		3 00	1-3/4" C x 3/4" C. Curb Cock	3 68
	1 hr. Trucking		75	1-Box & Rod	3 55
			26 81	1-1/2" Offset Tail Piece	30
				1-1/2" Straight Tail Piece	30
				1 hr. Trucking	75
					15 70

Com. 10/25/48

Reported

Non Charge

26 81

Hidley Press, Inc., Lexington

DATE _____

TOWN OF LEXINGTON—BOARD OF PUBLIC WORKS

WATER DIVISION

The undersigned applies for a supply of water at No. _____ St. and hereby agrees to comply with the rules and regulations as now, or at any future time, established by the Board of Selectmen.

Am't. of Estimate \$ _____


Owner _____

Am't. Paid \$ _____

Address _____

Builder _____

Sketch of Service Here

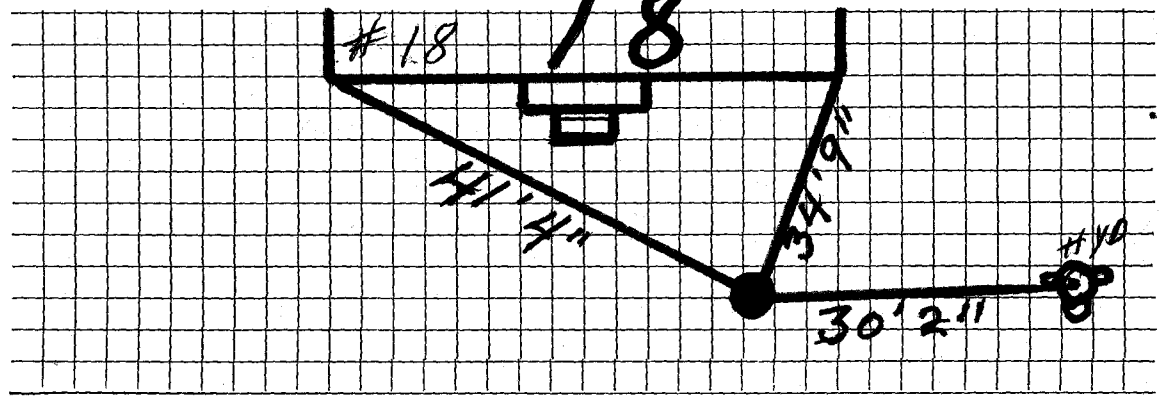

Connection made in _____ Street.

Work completed _____ 19

Remarks: