

**WATER SERVICE RECORD**

Name

Service No.

Address *2 Wilson Road*

Location


Repair—Renewal—New Service

Date		Material	Amount	Total	Date		Amount
7/19/41	4	hrs. @ .60	2.40		<i>7-7-41</i>	<i>Depos. J</i>	<i>30 00</i>
		10% O.H.	.24	2.64			
	60'	3/4" Copper tubing @.19		11.40			<i>18 54</i>
	1	3/4" C x 1/2" I.S. & W.		2.25			
	3	hrs. Trucking @ .75		2.25		Outside - W.O. #970	
				18.54	11/16/84	1 3/4" Curb	
						1 Curb Box & Rod	
						4 Tons - Gravel	
						Patch - 3/4 Ton Top	

TOWN OF LEXINGTON — BOARD OF PUBLIC WORKS

WATER DIVISION

Sketch of Service Here

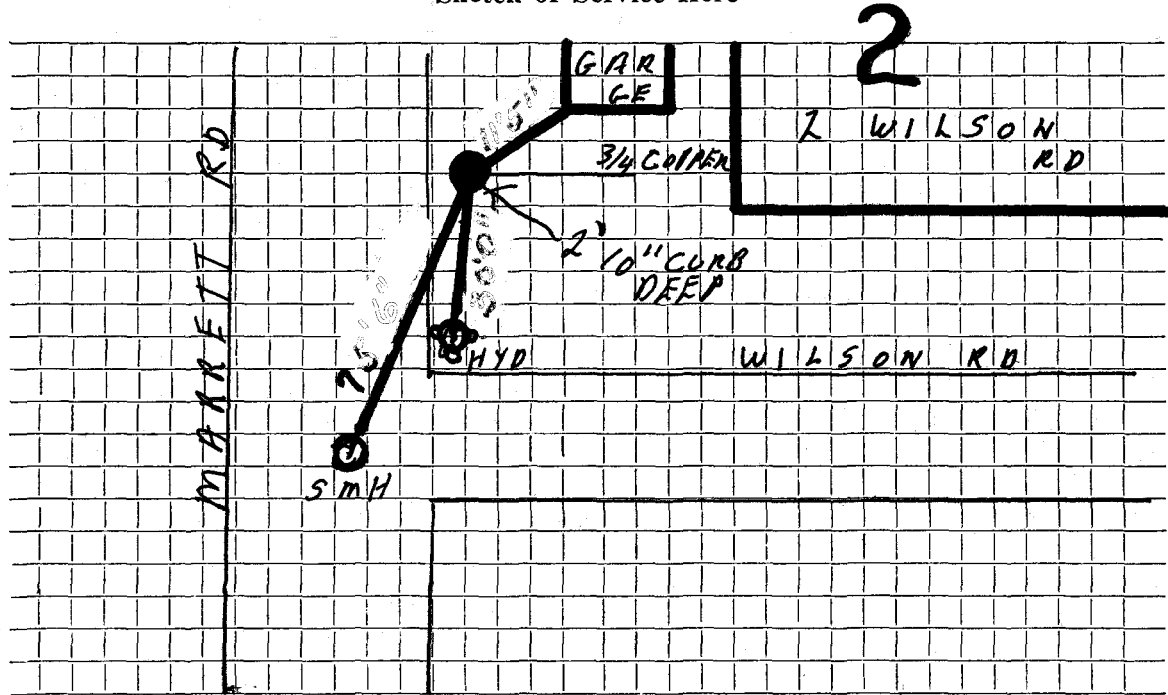

Connection made in ..... Street. Work completed .....

Remarks: .....

.....

.....