

Name Robert L. Innis

Service No. 222

Address 20 Wilson Road

Lexington, Mass.

Locatio 20 Wilson Road

Kind of Pipe

Size

Size of Main

~~Repair - Renewal~~ - New Service

Com. 11-6-50

Location

Date	Material	Amount	Total	Date	Location	Amount
Aug. 26, '50	Labor	2 55	2 55	Aug 12 '50	Deposited	40 00
	10% Overhead		26			
	48' - 3/4" Copper Tubing @.275		13 20		No Charge	34 05
	1 - 3/4"C x 1/2" I.W.H. S&W		3 29	Aug. 26, '50	Labor	3 83
	Littlefield Shovel 2 hrs. @7.00		14 00	Aug. 28, '50	Labor	1 25
	Trucking 1 hr. @.75		75	9' - 3/4" Copper Tubing @.275		2 48
			34 05	1 - 3/4"C Corp-cock		3 15
				1 - 3/4"C x 3/4"C Curb-cock		3 85
				1 - Box & Rod		3 35
				1 - 1/2" Offset Tail Piece		42
				1 - 1/2" Straight Tail Piece		42
				Littlefield Shovel 1 hr. @ 7.00		7 00
	Labor			Trucking 1 hr. @.75		75
						26 50

Hadley Press, Inc., Lexington

DATE _____

TOWN OF LEXINGTON—BOARD OF PUBLIC WORKS

WATER DIVISION

The undersigned applies for a supply of water at No. _____ St. and hereby agrees to comply with the rules and regulations as now, or at any future time, established by the Board of Selectmen.

Am't. of Estimate \$ _____


Owner _____

Am't. Paid \$ _____

Address _____

Builder _____

Sketch of Service Here

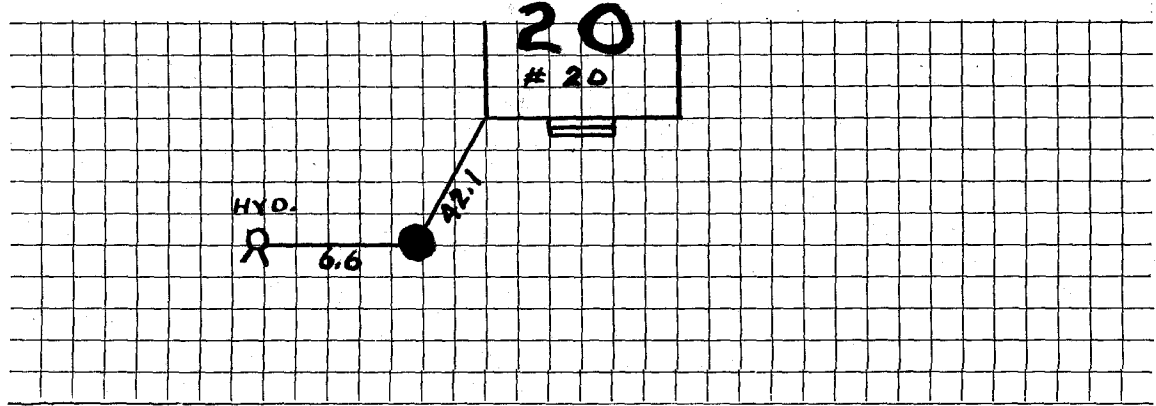

Connection made in _____ Street.

Work completed _____ 19

Remarks: