

Name Robert L. Innis

Service No. 229

Address 24 Wilson Road

# 1834

Lexington, Mass.

Location

Kind of Pipe

Size

Size of Main

~~Repair - Renewal~~ New Service

Location

Date	Material	Amount	Total	Date	Amount
Oct. 12, '48	Labor	3 15	3 15	Sept 30 '48	35 00
	10% Overhead		32	Dec. 31 '48	4 70
	35'-3/4" Copper Tubing @ .255		8 93		30 30
	1-3/4" C x 1/2" I.W.H. S&W		3 15	Oct. 12, '48	3 15
	2 hrs. Littlefield Shovel		14 00	7'-3/4" Copper Tubing @ .255	1 79
	1 hr. Trucking		75	1-3/4" C. Corp-cock	3 00
			30 30	1-3/4" C x 3/4" C. Curb-cock	3 68
				1-Box & Rod	3 55
				1 hr. Littlefield Shovel	7 00
				1-1/2" Offset Tail Piece	30
				1-1/2" Straight Tail Piece	30
				1 hr. Trucking	75
	Labor				23 52

Reported  
Refunded  
Non charge

Hadley Press, Inc., Lexington

DATE \_\_\_\_\_

# TOWN OF LEXINGTON—BOARD OF PUBLIC WORKS

## WATER DIVISION

The undersigned applies for a supply of water at No. \_\_\_\_\_ St. and hereby agrees to comply with the rules and regulations as now, or at any future time, established by the Board of Selectmen.

Am't. of Estimate \$ \_\_\_\_\_


Owner \_\_\_\_\_

Am't. Paid \$ \_\_\_\_\_

Address \_\_\_\_\_

Builder \_\_\_\_\_

Sketch of Service Here

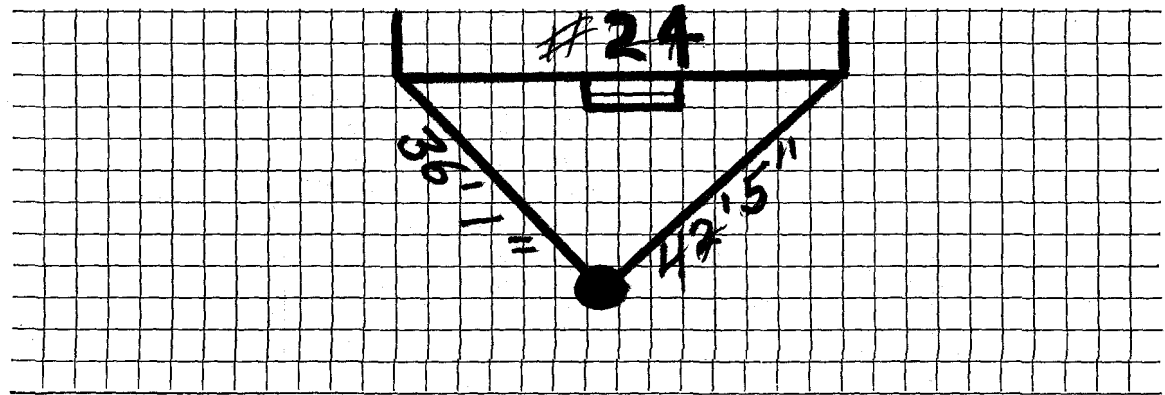

Connection made in \_\_\_\_\_ Street.

Work completed \_\_\_\_\_ 19

Remarks: