

WATER SERVICE RECORD

170

Name William E. Spiers, Jr.

Service No. 9

Address 30 Wilson Road

Location

~~Repair~~ ~~Renewal~~ - New Service


Committed 4-2-56

Date	Material	Amount	Total	Date	Amount
2-16-56	Labor	12 24		2-3-56	Deposited \$ 100 00
	10% overhead	1 22	13 46	4-2-56	Refunded 32 17
	40' - 3/4" Copper tubing @ .50		20 00		NON CHARGE 67 83
	1 - 3/4" Cx 1/2 I.W.H. Stop & Waste	8.50	4 96	2-17-56	Labor 23 57
	2 2/3 hrs. Littlefield Shovel @		22 66	10' - 3/4" Copper tubing @ .50	5 00
	1 hr. trucking		75	1 - 3/4" C. Corp Cock	4 34
	6x3 patching		6 00	1 - 3/4" C. Curb Cock	5 94
			67 83	1 box & rod	4 62
5/04	41' 1" copper			1 - 1/2 Straight tail piece	50
	1 3/4' union			1 - 1/2 Offset tailpiece	50
				1 hr. trucking	75
				4 2/3 hrs. Littlefield Shovel @ 8.50	39 66
					84 88

DATE _____

TOWN OF LEXINGTON — BOARD OF PUBLIC WORKS
WATER DIVISION

Below Sketch of Service Here

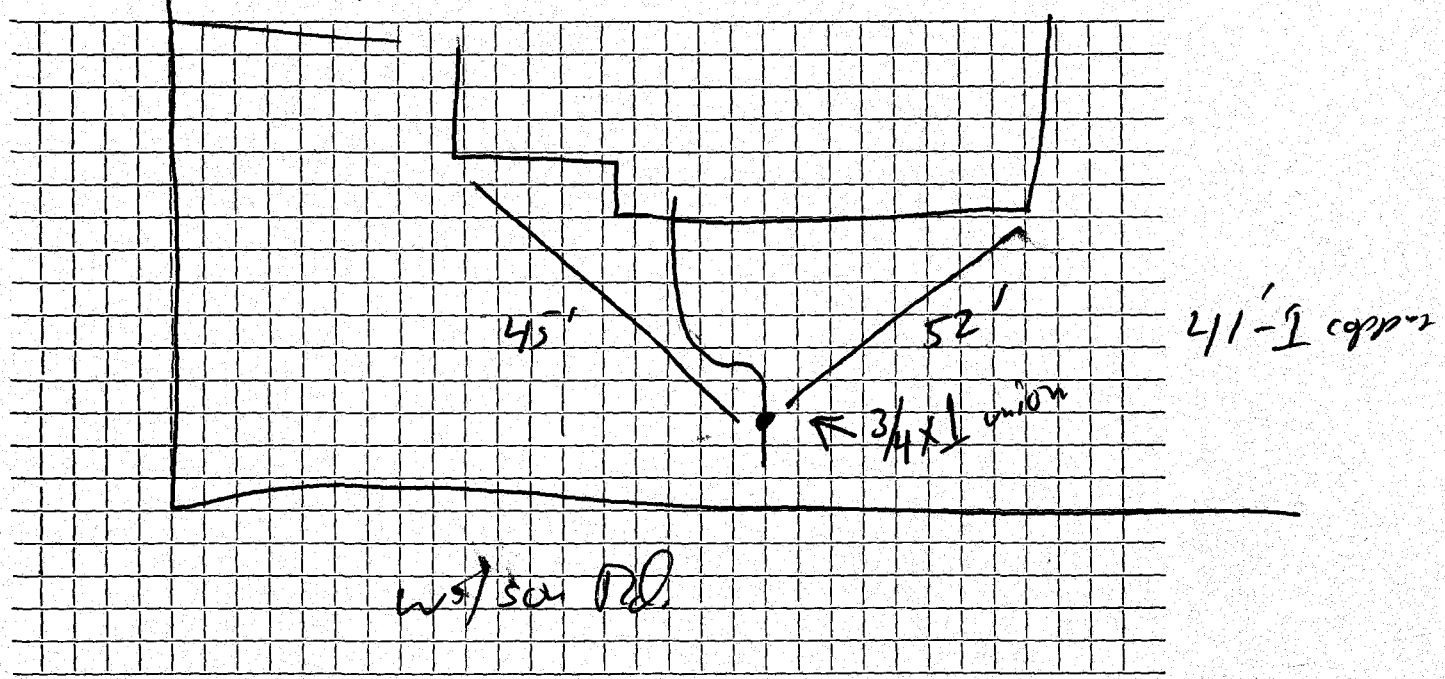

Connection made in *Wilson Rd* Street. Work completed

Remarks:
.....
.....