




DATE \_\_\_\_\_

TOWN OF LEXINGTON — BOARD OF PUBLIC WORKS

WATER DIVISION

10 WINCHESTER DRIVE

Sketch of Service Here

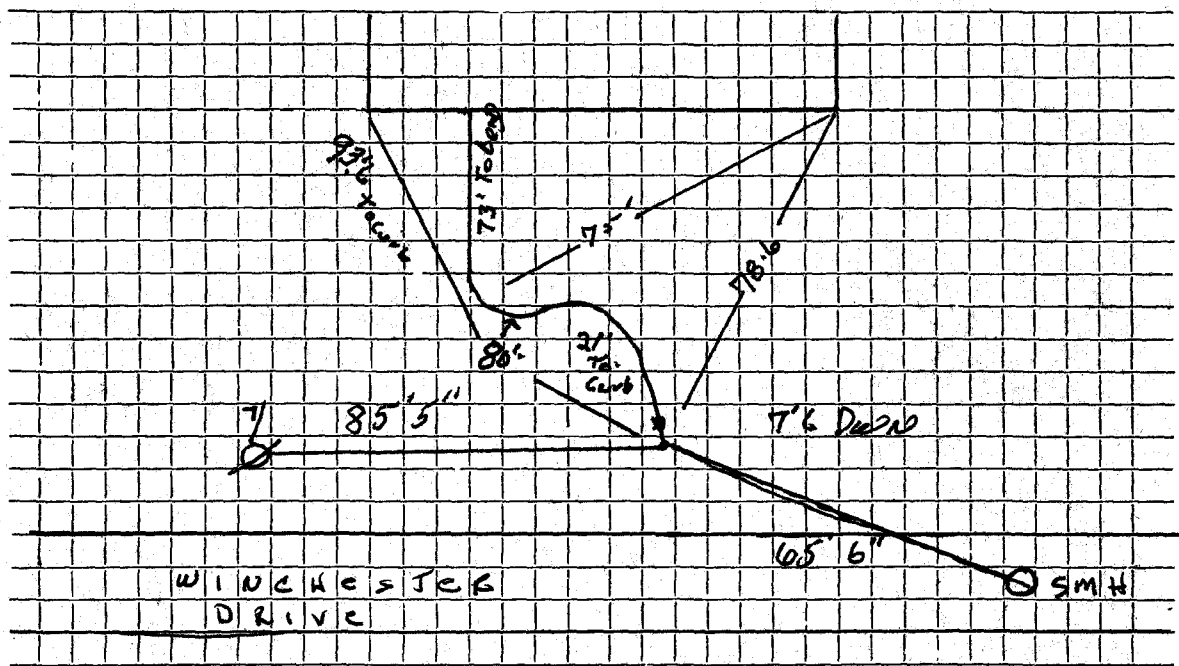

Connection made in ..... Street. Work completed .....

Remarks: NEXT To Sewer  
USE LONG CURB WRENCH