

## WATER SERVICE RECORD

2046

Service No. 409 n.d.

Name DeVries Const. Co., Inc.

Address 12 Winchester Drive

Location

~~Repair~~ ~~Renewal~~ - New Service

Com 12-31-55

Date	Material	Amount	Total	Date	Amount
11/15/55	Labor	1 85			
	10% overhead	19	2 04	1-12-56	47 71
	70' - 3/4" copper tubing@ .56		39 20		
	1 3/4" C. union		1 72	11/15/55	Labor 1 85
	1 - 3/4" C x 1/2 I.W.H. Stop & Waste	4 00		30' - 3/4" copper tubing@ .56	16 80
	1 hr. trucking		75	1 - 3/4" C. corp-cock	4 33
			47 71	1 - 3/4" C. curb-cock	4 67
				1 box and rod	3 90
				1 - 1/2 straight tail pc.	50
				1 - 1/2 offset tail pc.	50
					32 55

No Deposit  
Paid


NON CHARGE

DATE \_\_\_\_\_

# TOWN OF LEXINGTON — BOARD OF PUBLIC WORKS

## WATER DIVISION

Sketch of Service Here

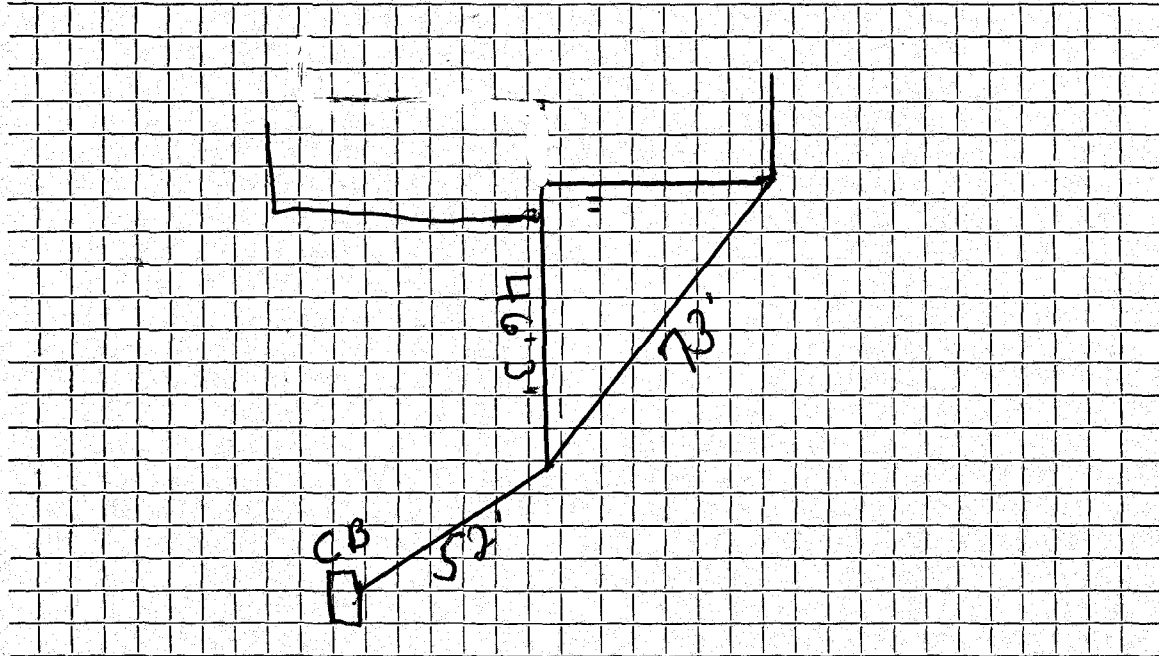

Connection made in ..... Street.      Work completed .....

Remarks: .....  
.....  
.....