

WATER SERVICE RECORD

Name DeVries Const. Co., Inc.

Service No. 410 n.d.

Address 14 Winchester Drive

Location

~~Repair - Renewal~~ - New Service

Com 12-31-55

Date	Material	Amount	Total	Date	Amount
11/15/55	Labor	1 85			
	10% overhead	19	2 04	1-10-56	44 91
	65' - 3/4" copper tubing@ .56		36 40		
	1 - 3/4" C. union		1 72	11/15/55	1 85
	1 - 3/4" C x 1/8 IWH stop & waste		4 00	30' - 3/4" copper tubing@ .56	16 80
	1 hr. trucking		75	1 - 3/4" C. corp-cock	4 33
			44 91	1 - 3/4" C. curb-cock	4 67
				1 box and rod	3 90
				1 - 1/8 straight tail pc.	50
				1 - 1/8 offset tail pc.	50
					32 55

No Deposit


Paid

NON CHARGE

DATE _____

TOWN OF LEXINGTON — BOARD OF PUBLIC WORKS
WATER DIVISION

Sketch of Service Here

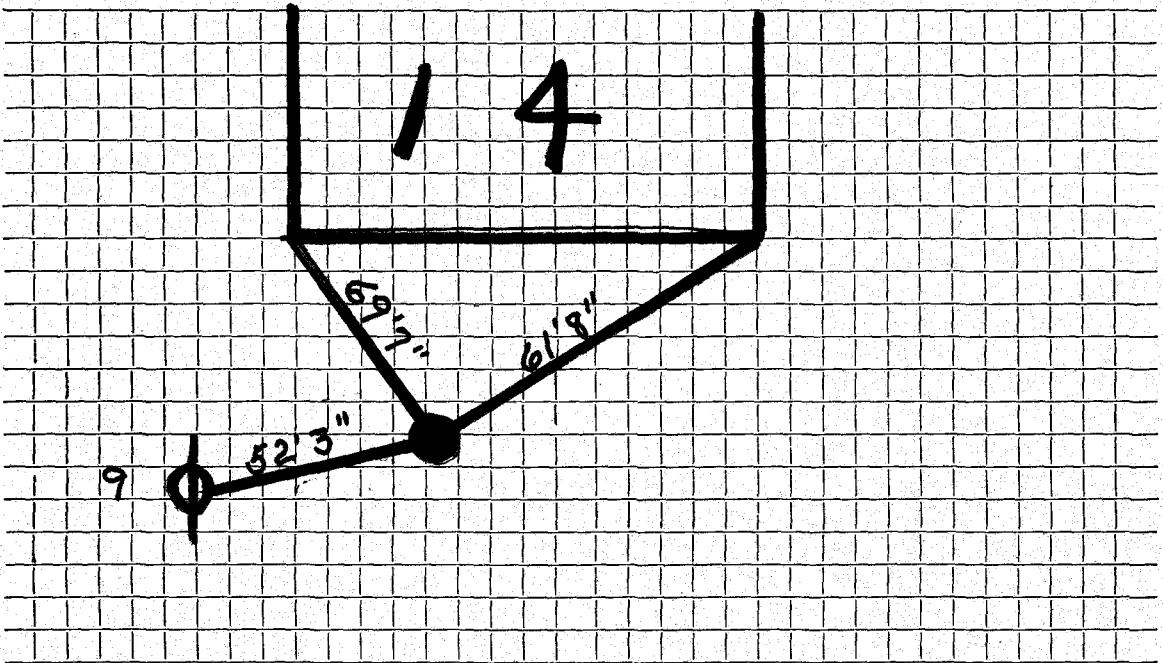

Connection made in Street. Work completed

Remarks:
.....
.....