

WATER SERVICE RECORD

Name DeVries Const. Co., Inc.

Service No. 412 n.d.

Address 16 Winchester Drive

Location

~~Repair~~ ~~Renewal~~ New Service

Com. 12-31-55

Date	Material	Amount	Total	Date	Amount
11/15/55	Labor	1 85			
	10% Overhead	19	2 04		
	65' - 3/4" copper tubing @ .56		36 40	1-10-56 2-23-56	
	1 Union (3 parts)		1 72		
	1 - 3/4Cx1/2" I.W.H. Stop & Waste		4 00		
	1 hr. trucking @ .75		75		
			44 91		
				Labor	
				30' - 3/4" copper tubing @ .56	16 80
				1 - 3/4 C. Corp Cock	4 33
				1 - 3/4 C. Curb Cock	4 67
				1 box & rod	3 90
				1 1/2" straight tail piece	50
				1 1/2" offset tail piece	50
					32 55

No Deposit

Paid 9/6

NON CHARGE

38 13

6 78

44 91

1 85

16 80

4 33

4 67

3 90

50

50


32 55

DATE _____

TOWN OF LEXINGTON — BOARD OF PUBLIC WORKS

WATER DIVISION

Sketch of Service Here

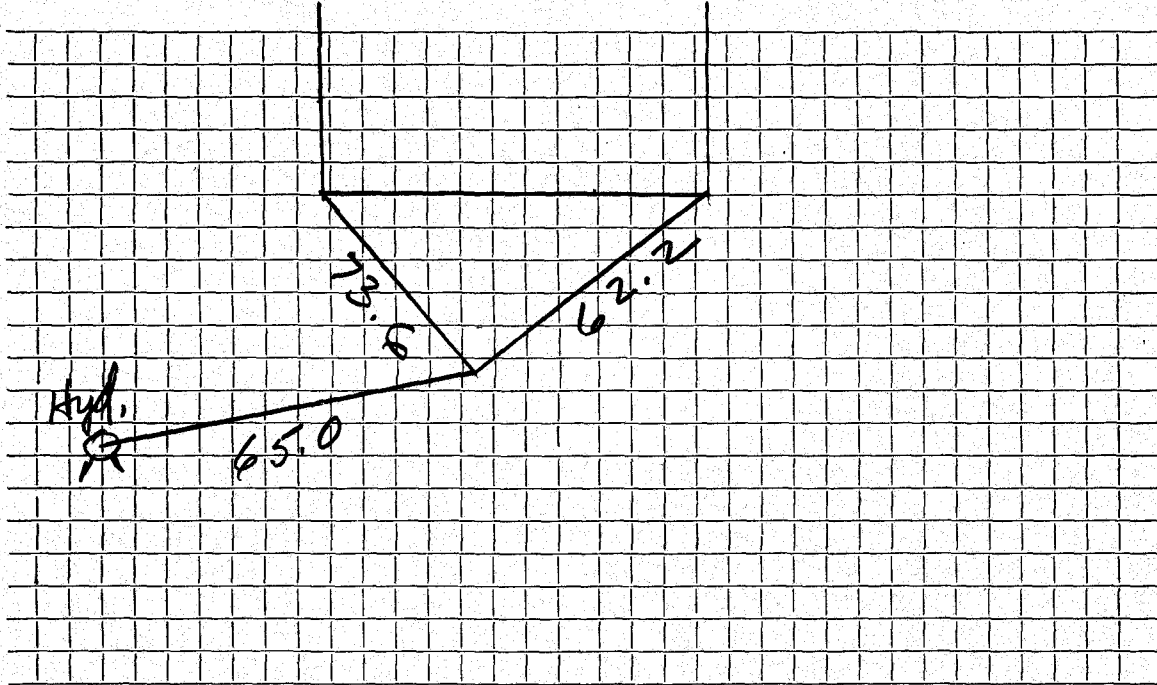

Connection made in Street. Work completed

Remarks:
.....
.....