

WATER SERVICE RECORD

Name Margaret Danielson

Service No. 81

Address 19 Winchester Drive

Location

Repair—Renewal—New Service

W.O. #811 Sprinkler System

MAR 14 1966

Date	Material	Amount	Total	Date	Amount
8-16-65	Labor	18.10		8-16-65	350 00
8-17-65	Labor	63.18	81 28	7-29-66	47 99
	10% O.H.	8 13	89 41		297 99
8'	1½" copper tubing @	1.93	15 44		
1	1½" Corp.		29 96		
1	1½ x 8 saddle		10 43		
	6 x 3 Patch		6 00		
1	Frame & cover		36 50		
132	Cement blocks @ .32		42 24		
½	Yd Loan @ 3.00		1 50		
¼	lb Grass seed @ .95		24		
1	Griseal curb		33 94		
1	Box & Rod		4 90		
1	Adapter		1 93		
2	Hrs. Town Truck @ 3.00		6 00		
3	Hrs. Town Tractor @ 6.50		19 50		
			297 99		
					Bill sent 47.99

DATE _____

TOWN OF LEXINGTON — BOARD OF PUBLIC WORKS

WATER DIVISION

Sketch of Service Here

A large grid of graph paper, consisting of 20 columns and 20 rows, intended for sketching service details.

Connection made in Street. Work completed


Remarks:
.....
.....

DATE _____

TOWN OF LEXINGTON — BOARD OF PUBLIC WORKS

WATER DIVISION

Sketch of Service Here

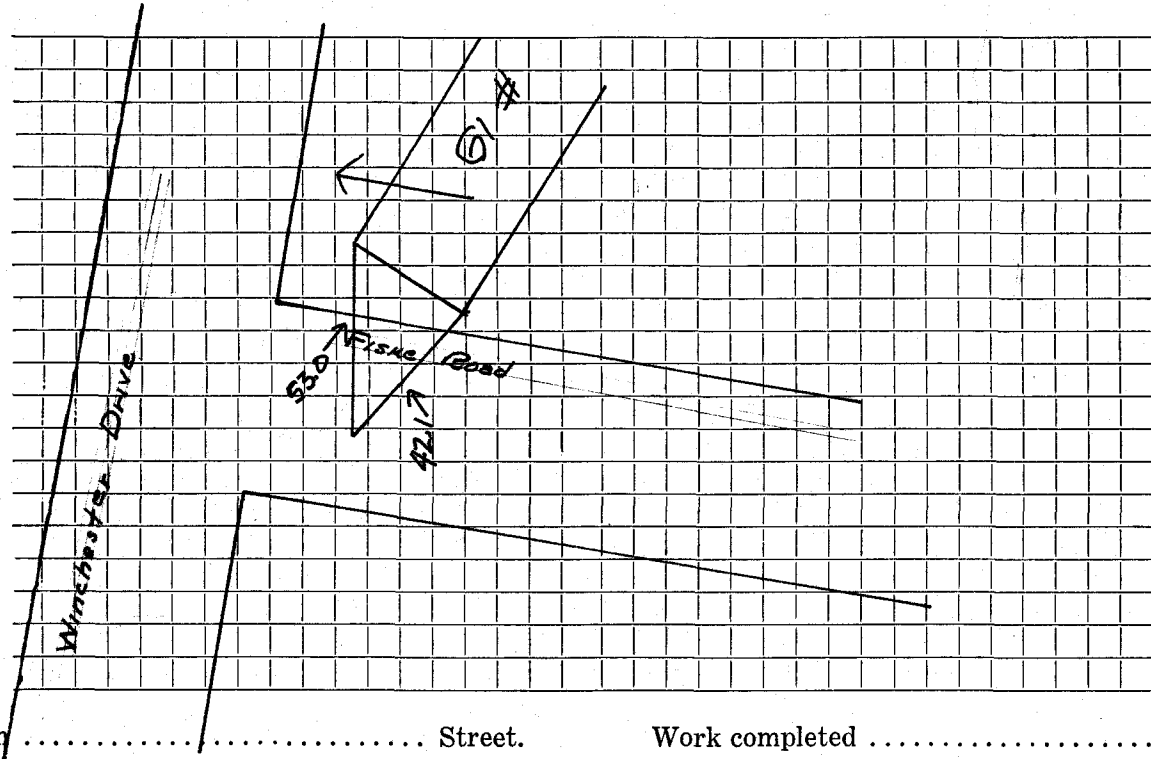

Connection made in Street. Work completed

Remarks:

.....

.....