

WATER SERVICE RECORD

Name Devries Construction Co.

Service No. 369
N.D.

Address 20 Winchester Dr., Lexington

Location

~~Renewal~~ ~~Renewal~~ - New Service

Comm. 11-21-55

Date	Material	Amount	Total	Date	Amount
10/21/55	Labor	1 85			
	10% Overhead	19	2 04	11-28-55	49 39
	73'-3/4" Copper tubing @.56		40 88		Non Charge
	1-3/4"x3/4"(3part) Union		1 72	10/21/55	Labor 1 85
	1-3/4"Cx1/2" I.W.H. stop & waste		4 00		15'-3/4" Copper tubing @.56 8 40
	1 hr. trucking @.75		75		1-3/4" C Corp Cock 4 33
			49 39		1-3/4" C Curb Cock 4 67
					1 Box & Rod 3 90
					1-1/2" straight tail piece 50
					1-1/2" offset tail piece 50
					1 hr. trucking @.75 75
					24 90


No Deposit Paid

DATE _____

TOWN OF LEXINGTON — BOARD OF PUBLIC WORKS

WATER DIVISION

Sketch of Service Here

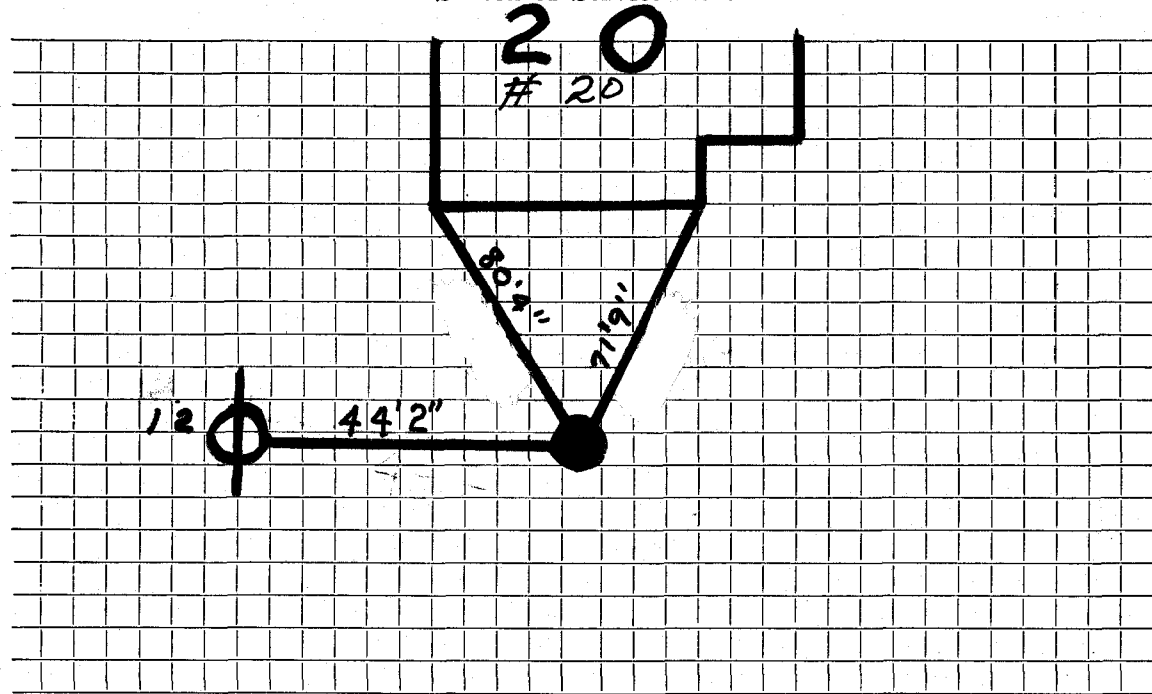

Connection made in Street. Work completed

Remarks:

.....

.....