

WATER SERVICE RECORD

Name DeVries Construction Co.

Service No. 367
N.D.

Address 22 Winchester Dr., Lexington

Location

~~Repair/Reconnect~~ New Service

Com. 11-21-55

Date	Material	Amount	Total	Date	Amount
10/15/55	Labor	1 85			
	10% Overhead	<u>19</u>	2 04		
	69'-3/4" Copper tubing @ .56		38 64		
	1-3/4" C x 1/2" I.W.H. stop & waste		4 00		
	1-3/4" C x 3/4" C Union (3 part)		1 72		
	1 hr. trucking @ .75		<u>75</u>		
			47 15		
				10/15/55	Labor
					1 85
				11-28-55	15'-3/4" Copper tubing @ .56
					8 40
					1-3/4" C Corp Cock
					4 33
					1-3/4" C Curb Cock
					4 67
					1 Box & Rod
					3 90
					1-1/2" straight tail piece
					50
					1-1/2" offset tail piece
					50
					1 hr. trucking @ .75
					<u>75</u>
					24 90

J. Deposit Paid

Non Charge


47 15

DATE _____

TOWN OF LEXINGTON — BOARD OF PUBLIC WORKS

WATER DIVISION

Sketch of Service Here

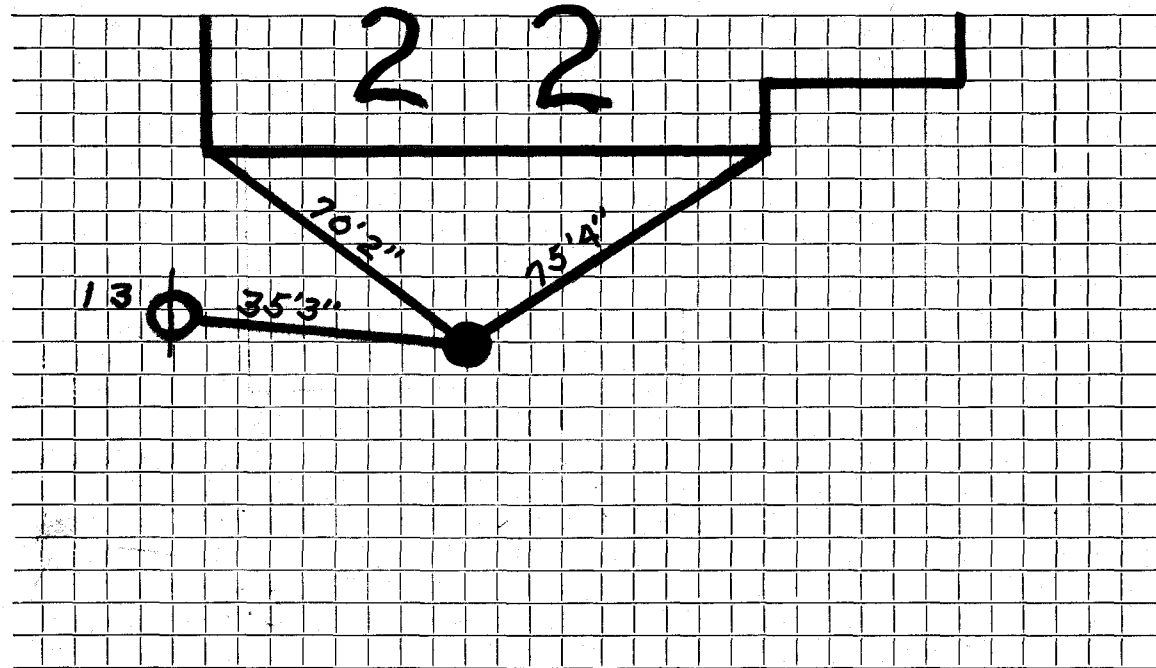

Connection made in Street. Work completed

Remarks:
.....
.....