

#4817  
368  
N.D.

WATER SERVICE RECORD

Name DeVries Construction Co. Service No.

Address 24 Winchester Dr., Lexington

Location

~~Repair~~ ~~Renewal~~ New Service Com. 11-21-55

Date	Material	Amount	Total	Date	Amount
10/21/55	Labor	1 85			
	10% Overhead	19	2 04	11-28-55	35 35
	51'-3/4" Copper tubing @.56		28 56		
	1-3/4"C x 1/2" I.W.H. stop & waste		4 00		
	1 hr. trucking @.75		75		
			35 35		
				10/21/55	
				Labor	1 85
				15'-3/4" Copper tubing @.56	8 40
				1-3/4" C Corp Cock	4 33
				1-3/4" C Curb Cock	4 67
				1 Box & Rod	3 90
				1-1/2" straight tail piece	50
				1-1/2" offset tail piece	50
				1 hr. trucking @.75	75
					24 90


*No Deposit*  
*Paid*  
Non Charge

DATE \_\_\_\_\_

TOWN OF LEXINGTON — BOARD OF PUBLIC WORKS

**WATER DIVISION**

Sketch of Service Here

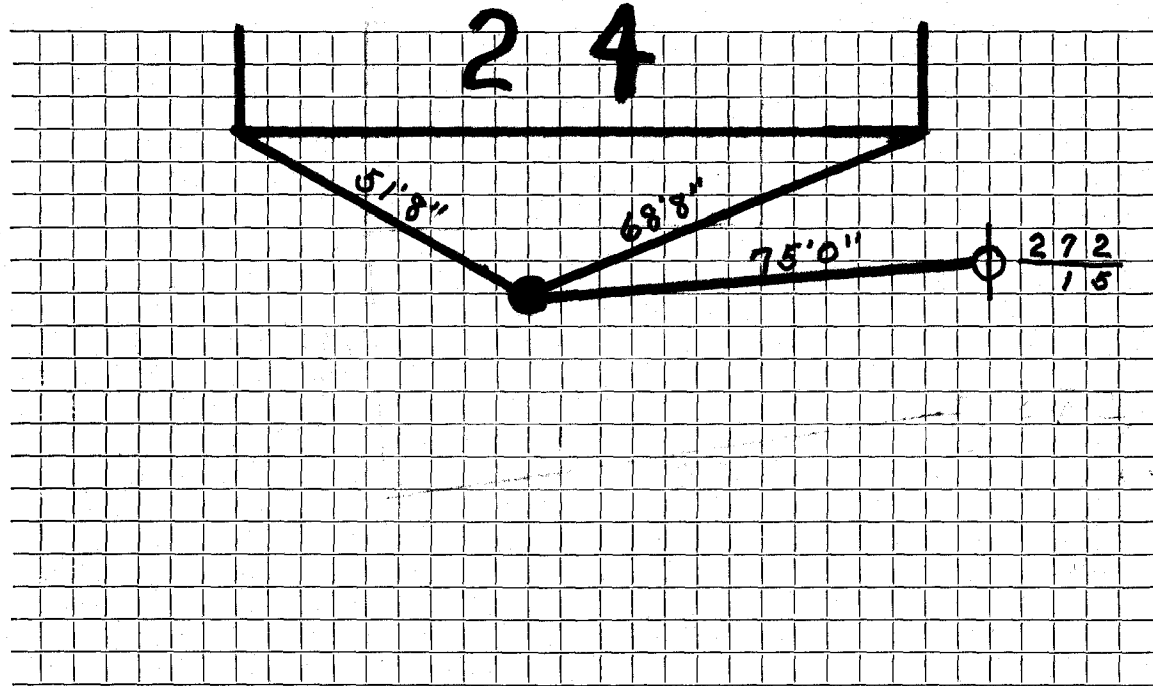

Connection made in ..... Street.      Work completed .....

Remarks: .....

.....

.....