

WATER SERVICE RECORD

1334

366
N.D.

Name DeVries Construction Co.

Service No.

Address 26 Winchester Dr., Lexington

Location

Repair—Renewal—New Service

Com. 11-21-55

Date	Material	Amount	Total	Date	Amount
10/20/55	Labor	1 85			
	10% Overhead	19	2 04	11-28-55	38 15
	56'-3/4" Copper tubing @.56		31 36		
	1-3/4"C x 1/2" I.W.H. stop & waste		4 00		
	1 hr. trucking @.75		75		
			38 15		
				10/20/55	1 85
				15'-3/4" Copper tubing @.56	8 40
				1-3/4" C Corp Cock	4 33
				1-3/4" C Curb Cock	4 67
				1 Box & Rod	3 90
				1-1/2" offset tail piece	50
				1-1/2" straight tail piece	50
				1 hr. trucking @.75	75
					24 90

No Deposit Paid


Non Charge

DATE _____

TOWN OF LEXINGTON — BOARD OF PUBLIC WORKS

WATER DIVISION

Sketch of Service Here

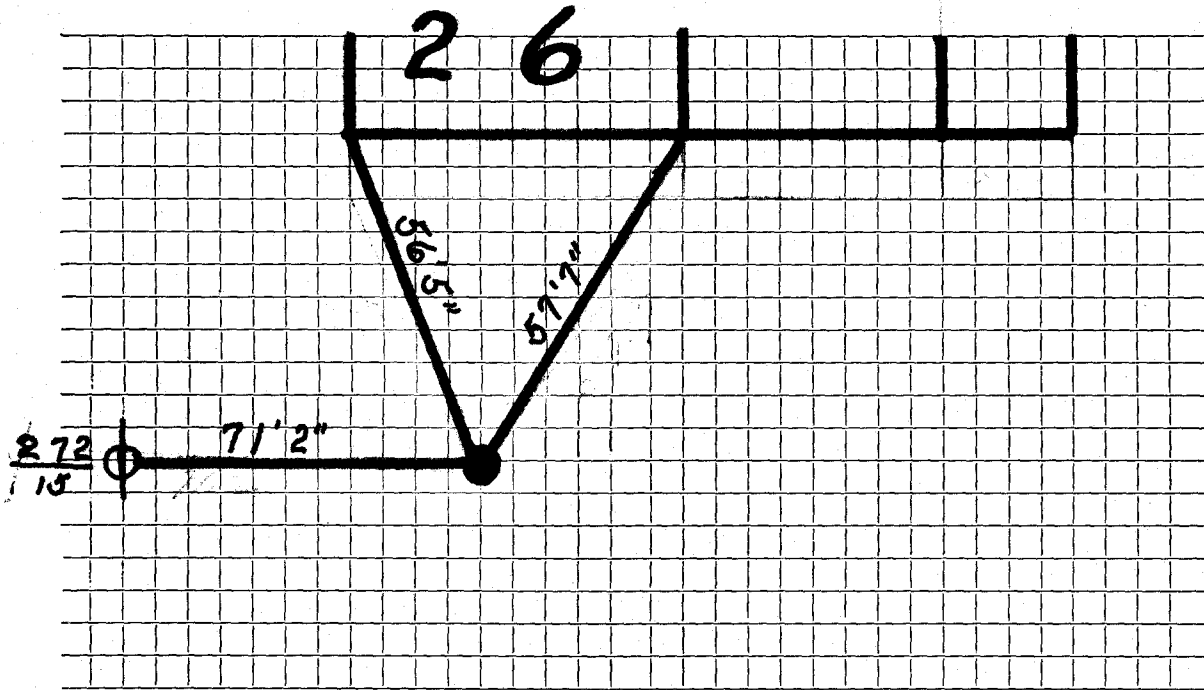

Connection made in Street. Work completed

Remarks:

.....

.....