

WATER SERVICE RECORD

Name DeVries Construction Co.
 Address 27 Winchester Drive, Lexington
 Location Md1; 72 Albion St., Wakefield, Mass.

Service No. 359
 N.D.

#7280

~~REPAIR-RENEWAL~~ - New Service

Com. 11-21-55

Date	Material	Amount	Total	Date	Amount
10/21/55	Labor	1 85			
	10% Overhead	***19	2 04	11-28-55	31 43
	44'-3/4" Copper tubing @ .56		24 64		
	1-3/4" C x 1/2" I.W.H. stop & waste		4 00		
	1 hr. trucking @ .75		75	10/21/55	1 85
			31 43	23'-3/4" Copper tubing @ .56	12 88
				1-3/4" C Corp Cock	4 33
				1-3/4" C x 3/4" C Curb Cock	4 67
				1 Box & Rod	3 90
				1-1/2" straight tail piece	50
				1-1/2" offset tail piece	50
				1 hr. trucking @ .75	75
					<u>29 38</u>

*To Deposit
 Paid*

Non Charge


DATE _____

TOWN OF LEXINGTON — BOARD OF PUBLIC WORKS

WATER DIVISION

Sketch of Service Here

27 WINCHESTER

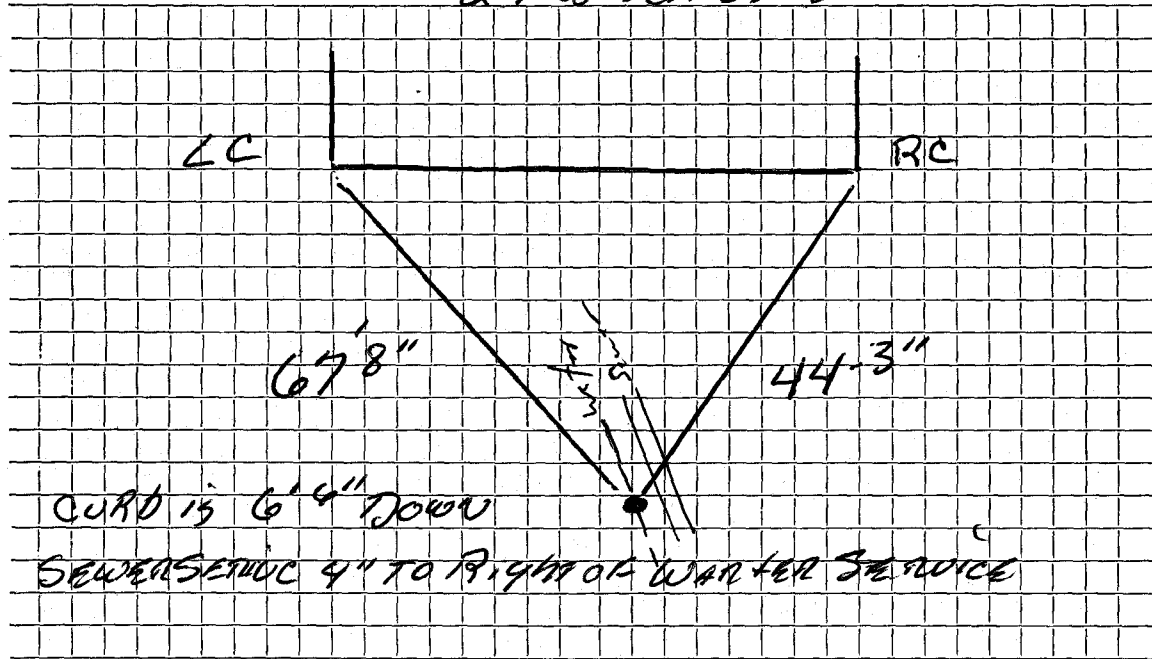

Connection made in Street. Work completed

Remarks:

.....

.....