

WATER SERVICE RECORD

#284
365 #4549
N.D.

Name Devries Construction Co.
Address 28 Winchester Dr., Lexington

Service No.

Location

~~Repair Work~~ New Service

Com. 11-21-55


Date	Material	Amount	Total	Date	Amount
10/20/55	Labor	1 85			
	10% Overhead	19	2 04	11-28-55	44 91
	65'-3/4" Copper tubing @.56		36 40		Non Charge
	1-3/4"C x 1/2 I.W.H. stop & waste		4 00	10/20/55	Labor
	1-3/4" x 3/4" Union (3part)		1 72		15'-3/4" Copper tubing @.56
	1 hr. trucking @.75		75		1-3/4"C Corp Cock
			44 91		1-3/4" C Curb Cock
					1 Box & Rod
					1-1/2" straight tail piece
					1-1/2" offset tail piece
					1 hr. trucking @.75
					<u>24 90</u>

DATE _____

TOWN OF LEXINGTON — BOARD OF PUBLIC WORKS

WATER DIVISION

Sketch of Service Here

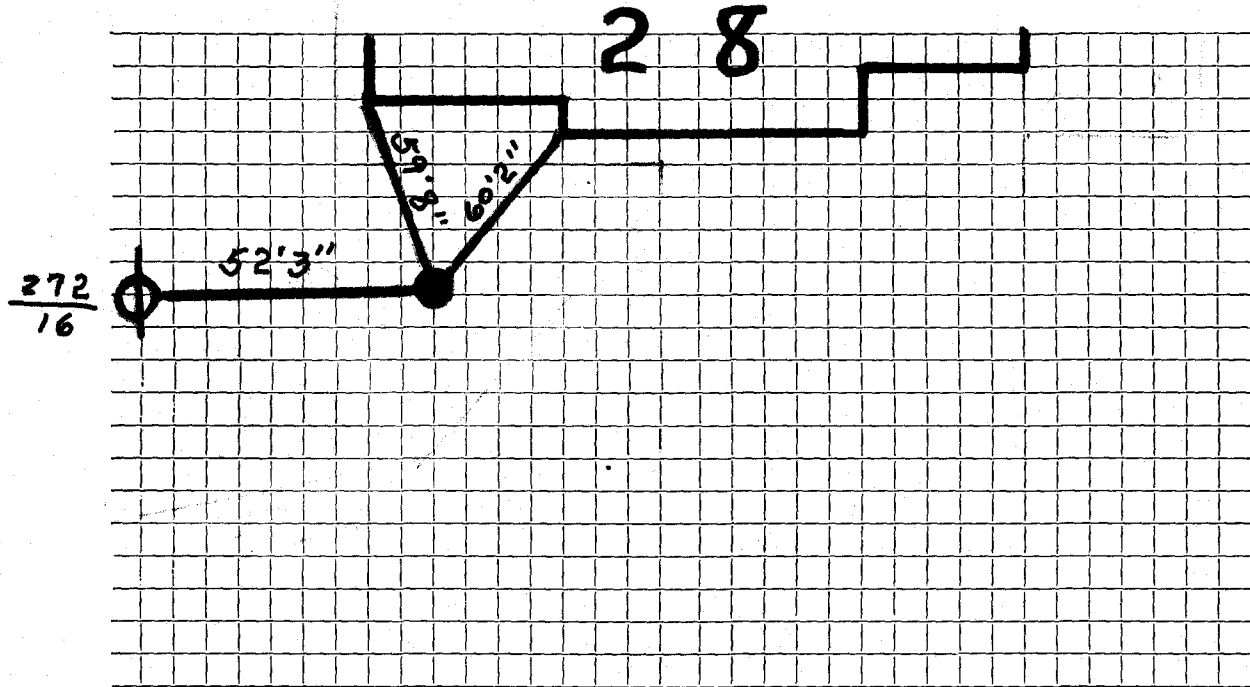

Connection made in Street. Work completed

Remarks:

.....

.....