

WATER SERVICE RECORD

Name DeVries Construction Co.

Service No. 358
N.D.

Address 29 Winchester Drive, Lexington

Location Mail; 72 Albion St., Wakefield

~~Repair - Renewal~~ New Service

Com. 11-21-55


Date	Material	Amount	Total	Date	Amount
Oct. 21/55	Labor	1 85			
	10% Overhead	19	2 04	11-28-55	39 83
	59'-3/4" Copper tubing @.56		33 04		
	1-3/4" Cx 1/2" I.W.H. stop & waste	4 00		10/21/55	Labor 1 85
	1 hr. trucking @.75		75	25'-3/4" Copper tubing @.56	14 00
			39 83	1-3/4" C Corp Cock	4 33
				1-3/4" Cx 3/4" C Curb Cock	4 67
				1 Box & Rod	3 90
				1-1/2" straight tail piece	50
				1-1/2" offset tail piece	50
				1 hr. trucking @.75	75
					30 50

DATE _____

TOWN OF LEXINGTON — BOARD OF PUBLIC WORKS

WATER DIVISION

Sketch of Service Here

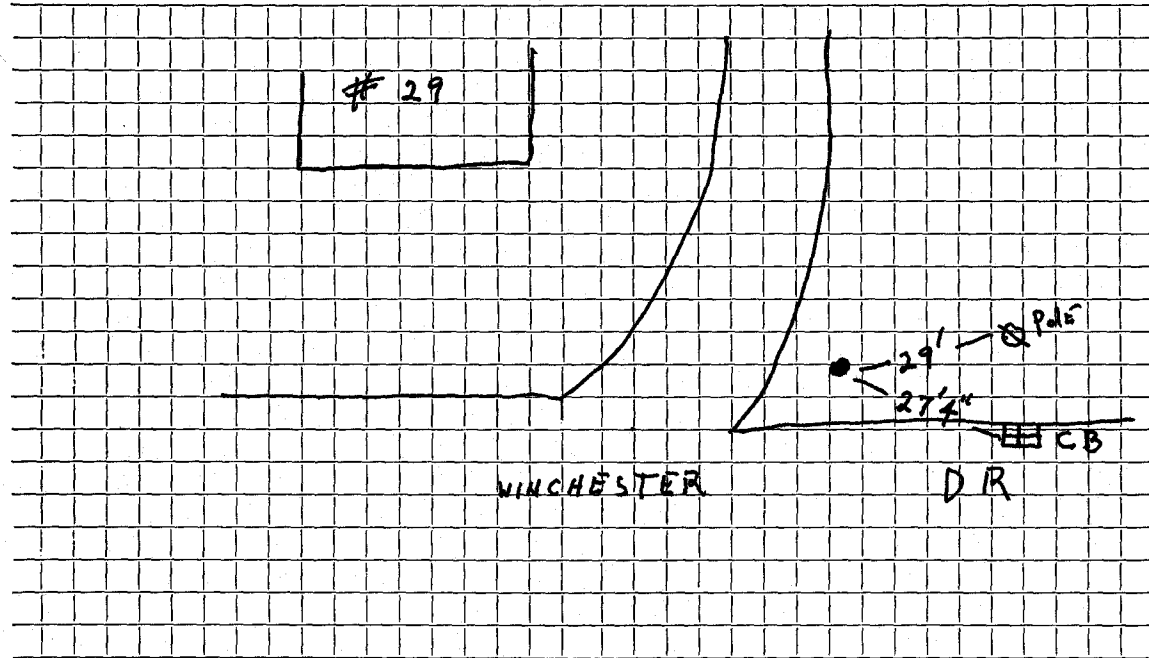

Connection made in Street. Work completed

Remarks:

.....

.....