


DATE _____

TOWN OF LEXINGTON — BOARD OF PUBLIC WORKS
WATER DIVISION

Sketch of Service Here

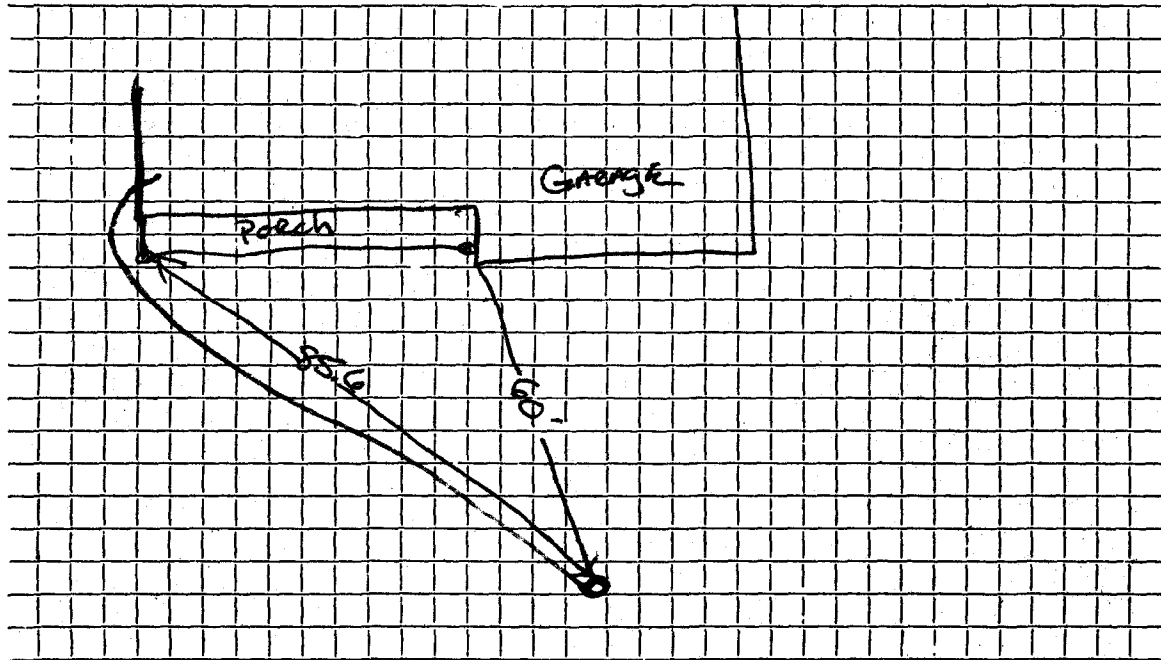

Connection made in Street. Work completed

Remarks: SERVICE RENEWED INSIDE
HOUSE WAS TORN DOWN - NEW HOUSE BUILT