

WATER SERVICE RECORD

#6472
362
 N.D.

Name DeVries Cnstruction Co.

Service No.

Address 30 Winchester Dr., Lexington

Location

~~Repair - Renewal~~ - New Service

Com. 11-21-55

Date	Material	Amount	Total	Date	Amount
10/20/55	Labor	1 85			
	10% Overhead	19	2 04		
	69'-3/4" Copper tubing @.56		38 64		
	1-3/4" x 3/4" Union (3part)		1 72	10/20/55	Labor 1 85
	1-3/4"C x 1/2" I.W.H. stop & waste		4 00	10'-3/4" Copper tubing @.56	5 60
	1 hr. trucking @.75		75	1-3/4"C. Corp Cock	4 33
			47 15	1-3/4"C. Curb Cock	4 67
				1 Box & Rod	3 90
				1-1/2" straight tail piece	50
				1-1/2" offset tail piece	50
				1 hr. trucking @.75	75
					<u>22 10</u>


*By Deposit
 Paid*

DATE _____

TOWN OF LEXINGTON — BOARD OF PUBLIC WORKS

WATER DIVISION

Sketch of Service Here

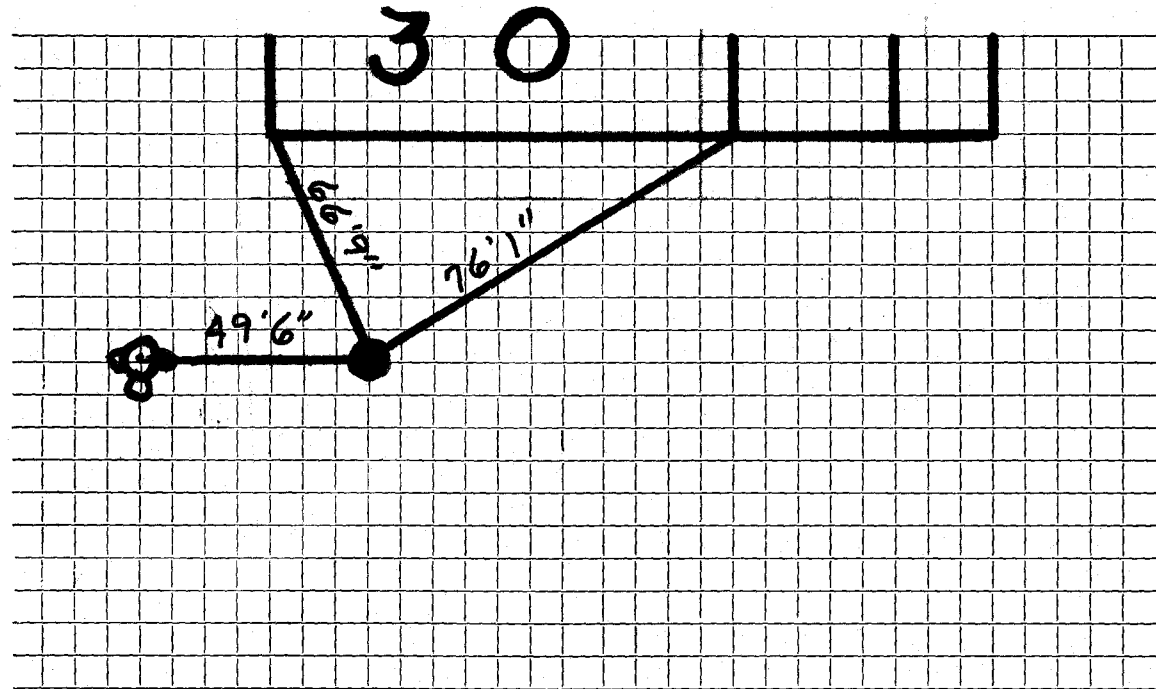

Connection made in Street. Work completed

Remarks:
.....
.....