

WATER SERVICE RECORD

Name DeVries Construction Co., Inc.

Service No. 415 N.D.

Address 34 Winchester Drive

2154

Location


~~REPAIR/RENEW~~ - New Service

Com. 12-31-55

Date	Material	Amount	Total	Date	Amount
11/21/55	Labor	1 85		2-23-56	8 51
	10% overhead	19	2 04		
	See Remarks				NON CHARGE
	1 Union (3 parts)	1 72	1 72	Labor	1 85
	1 - 3/4Cx1/2" I.W.H. Stop & Waste		4 00	18' - 3/4" copper tubing @ .56	10 08
	1 hr. trucking		75	1 - 3/4C. Corp cock	4 33
			8 51	1 - 3/4C. curb cock	4 67
				1 box & rod	3 90
				1 - 1/2" straight tail piece	50
				1 - 1/2" offset tail piece	50
	75' copper supplied by town to				25 83
	reimburse owner for their copper used				
	on other jobs.				
					Bill sent 1-10-56

TOWN OF LEXINGTON — BOARD OF PUBLIC WORKS
WATER DIVISION

Sketch of Service Here

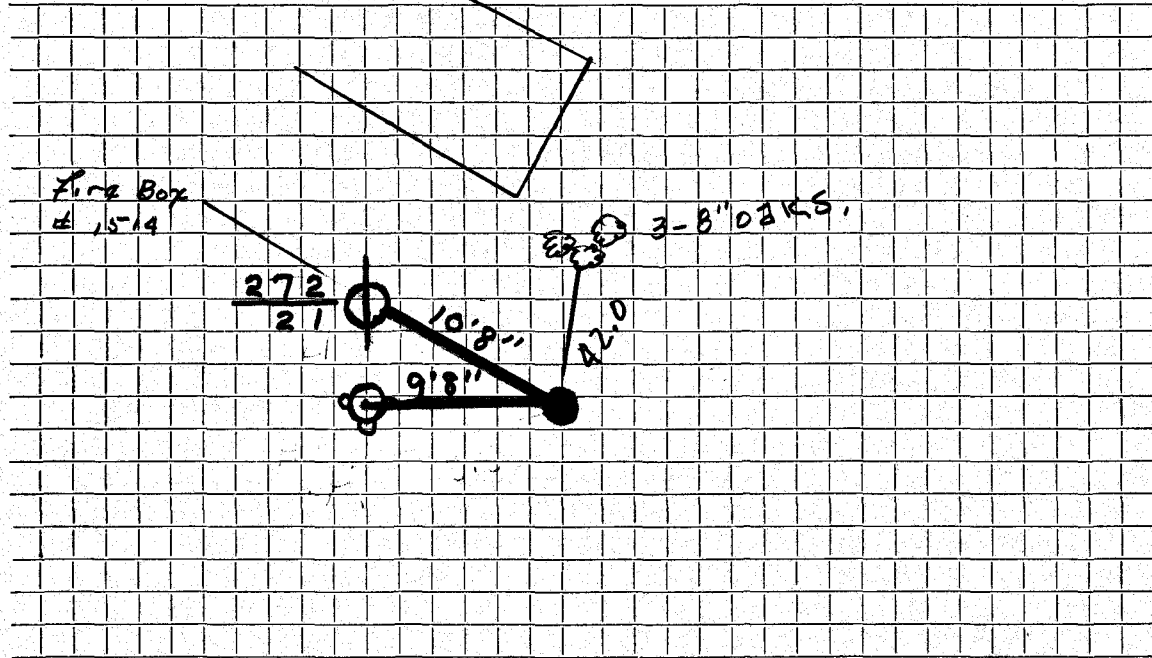

Connection made in Street. Work completed

Remarks:
.....
.....