




Date: 4/25/23

TOWN OF LEXINGTON - BOARD OF PUBLIC WORKS  
WATER SEWER DIVISION

SKETCH OF SERVICE HERE

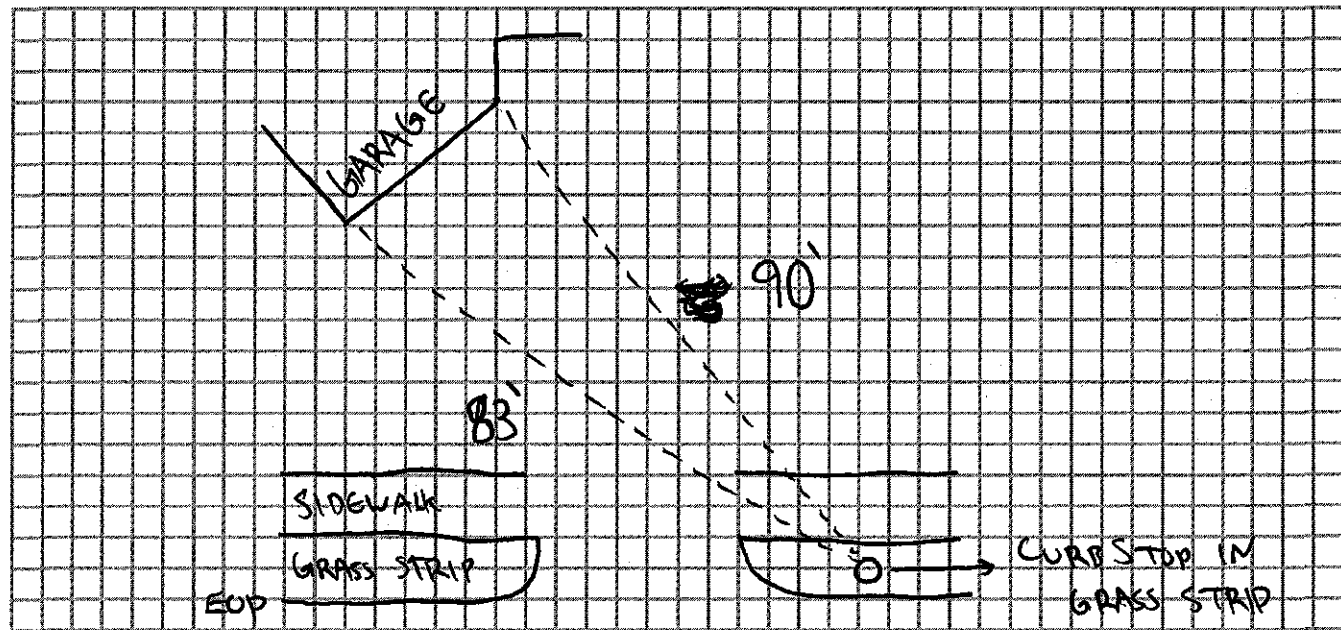

Connection made in: \_\_\_\_\_ Street. Work completed: \_\_\_\_\_  
Remarks: INSTALLED BY TBR Excavating