


TOWN OF LEXINGTON - BOARD OF PUBLIC WORKS
WATER DIVISION

Date: ~~2/15/24~~
2/21/24

SKETCH OF SERVICE HERE
40 Winchester Dr.

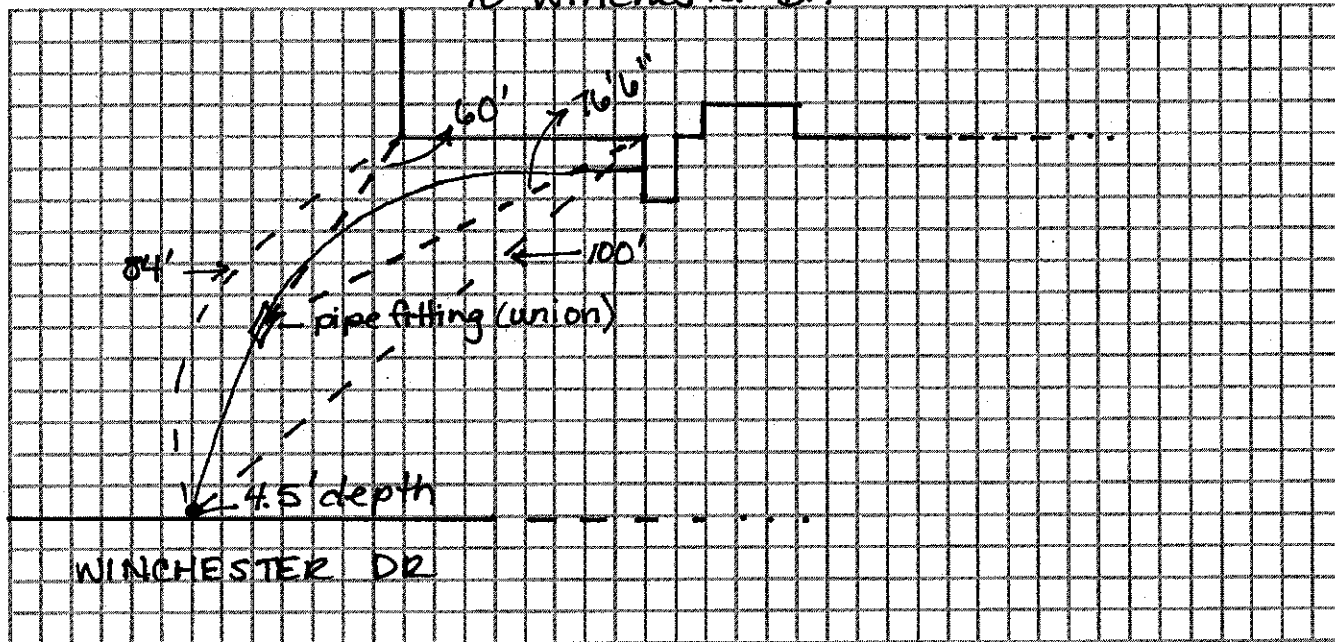

Connection made in:

Street.

Work completed:

Remarks: Installed by TBR Excavating