

## WATER SERVICE RECORD

Name Leonard Friedman SPRINKLER SYSTEM

Service No. 33

Address 6 Winchester Drive

Location

Repair—Renewal—New Service Dick McGrath #679 W.O. #4914

AUG 5 1968

Date	Material	Amount	Total	Date	Amount
6-26-67	Labor 115.92			6-21-67	450 00
6-27-67	" 62.12			7-5-68	90 47
7-6-67	" 31.33	209.37			530 71
	10% O.H.	20.94	230.31		
	24' 2" Copper tubing @2.30		55.20		
	1 8 x 2 Service Saddle		10.07		
	1 2" Corp Cock		30.18		
	1 2" Curb Cock		49.02		
	1 2" Adapter		11.46		
	1 2" Wheel Valve		20.91		
	1 2 x 4 Nipple		2.79		
	1 Gate Box		13.40		
	2½ Ton Cold Patch @5.50		14.38		
	1 hr. Roller & Trailer		5.00		
	6½ hrs. Trucking @3.00		19.50		
	5½ hrs. Town Shovel @6.50		35.75		
	½ hr. Compressor @5.00		2.50		
			540.47		Bill sent 20.47

DATE \_\_\_\_\_

**TOWN OF LEXINGTON — BOARD OF PUBLIC WORKS**

**WATER DIVISION**

Sketch of Service Here

A large grid of graph paper, consisting of 20 columns and 20 rows, intended for sketching service details.

Connection made in ..... Street.      Work completed .....

Remarks: .....  
.....  
.....

WATER SERVICE RECORD

Name DeVries Const. Company

#13473

Service No. 209

Address 6 Winchester <sup>Drive</sup> ~~Road~~

Location

Repair—Renewal—New Service

Com. of - 15-55

Date	Material	Amount	Total	Date	Amount
4/14/55	Labor	1 85			
	10% Overhead	19	2 04	4-15-55	39 90
	85' - 3/4" Copper tubing @ .3693		31 39		
	1 - 3/4" C x 1/2 I.W.H. stop & waste	4 00	4/14/55	Labor	5 27
	1 - 3/4" C x 3/4" C. Union 3 pts.	1 72	24' - 3/4" Copper tubing @ .3693		8 86
	1 hr. trucking		75	1 - 3/4" C. corp-cock	4 33
			39 90	1 - 3/4" C x 3/4" C. curb-cock	4 67
				1 box and rod	3 90
				1 - 1/2 offset tail piece	50
				1 - 1/2 straight tail piece	50
				1 hr. trucking	75
					28 78
TRENCH DUG BY OWNER					

*no deposit  
Paid*


NON CHARGE

DATE \_\_\_\_\_

# TOWN OF LEXINGTON — BOARD OF PUBLIC WORKS

## WATER DIVISION

Sketch of Service Here

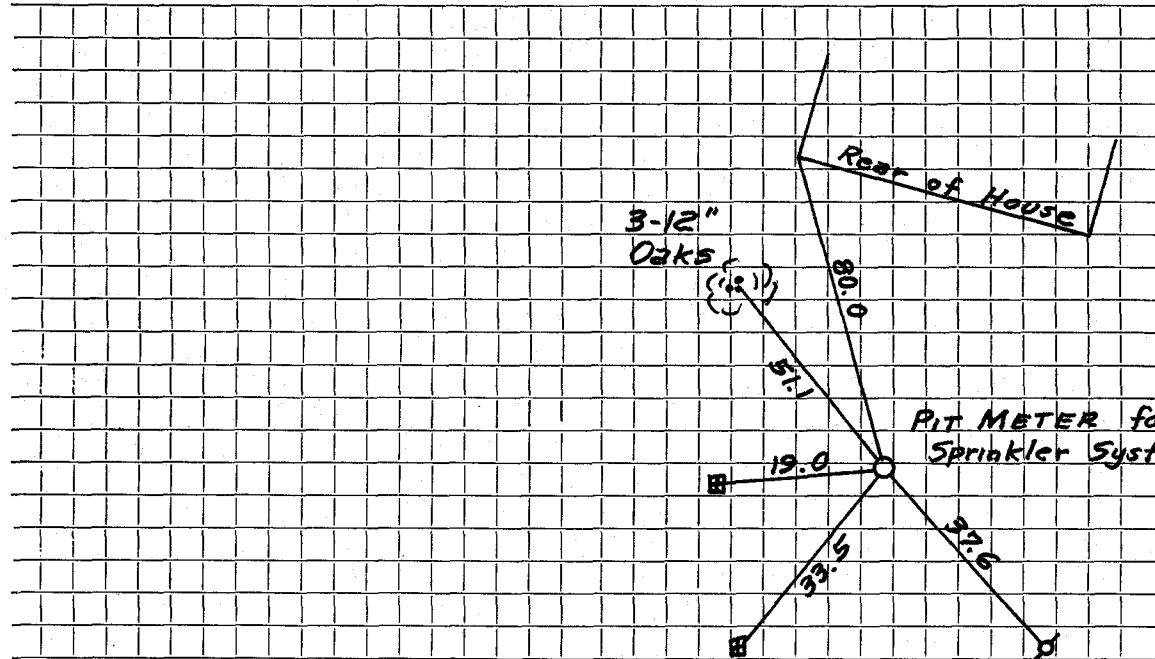

Note: Connection made on Tyler Rd. (this is not house) service  
Work done by Town 6/29/67

Connection made in ..... Street. Work completed .....

Remarks: .....

.....

.....