

WATER SERVICE RECORD

Name Arthur Ruge

Service No. 52

Address 14 Wingate Road

Location

~~Repair~~ ~~Removal~~ ~~New Service~~ W.O. #8803

FEB 15 1965


Date	Material	Amount	Total	Date	Amount
6-17-64	Labor	77.85		5-25-64	150.00
6-19-64	"	89.14	166.99	5-23-65	411.99
	10% O.H.	16.70	183.69		561.99
	3' 2" Copper tubing @1.30		3.90		CURB TO MAIN
	1 5' Manhole		35.00	24'	2" Copper tubing @1.30
	23 x 3 Patch		23.00	1	2" Corp Cock
	2 hrs. Town Shovel @6.50		13.00	1	2" Oriseal Curb Cock
			292.59	1	Box & Rod
			269.40	55	Sticks Dynamite @.27
			561.99	29	Blasting Caps @.28
				23 1/2	ton fill @.70
				4	hrs. Town Shovel @6.50
				6	hrs. Trucking @3.00
				9	hrs. Compressor @ 5.00
					269.40
					Call sent 411.99

DATE _____

TOWN OF LEXINGTON — BOARD OF PUBLIC WORKS

WATER DIVISION

Sketch of Service Here

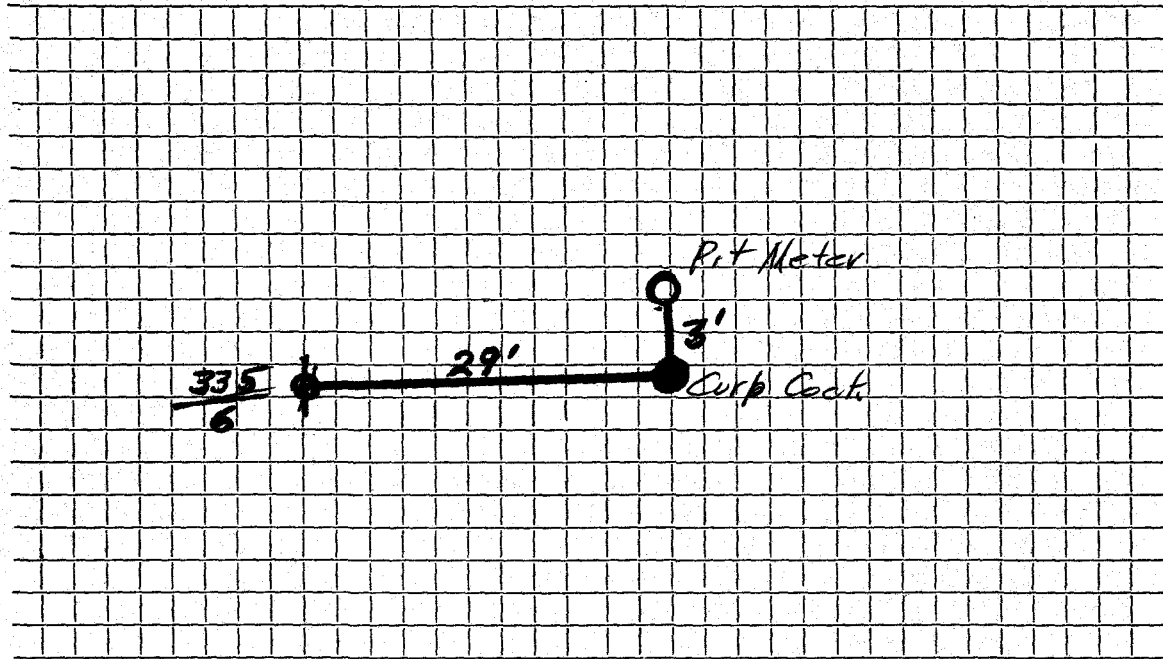

Connection made in Street. Work completed

Remarks:

.....

.....

50 Hill St.
Lexington, Mass.
May 22, 1964

Mr. John J. Carroll
Superintendent of Public Works
Lexington, Mass.

Dear Mr. Carroll:


Enclosed please find my check in the amount of \$150.00 as payment against your estimate for a water service connection at 50 Hill St. from Wingate Road.

It is my intention to have Mr. Vernon Page install a plastic pipe distribution system which will be used during the growing season for watering trees, lawns, and gardens. The system will be shut off and drained during the winter season.

This will be an entirely private responsibility on my part and the Town of Lexington will not have any responsibility for digging up or repairing of the system in case of a failure at any time in the future.

Thanking you for your cooperation, I am

Very truly yours,


Arthur C. Ruge

ACR:FBR