

WATER SERVICE RECORD

Name

Service No.

Address

4 Wingate Road

3317

Location

~~Repair - Renewal~~ - New Service


Date	Material	Amount	Total	Date	Amount
6-15-56					
	60' 3/4" Copper				
	1 3/4" C. X 1/2" I.W.H. Stop + Waste				
					Non Charge
				9/16/55	Labor 1 60
					21' - 3/4" Copper tubing @.56 11 76
					1 - 3/4" C Corp Cock 4 33
					1 - 3/4" C Curb Cock 4 67
					1 Box & Rod 3 90
					1 hr. trucking @.75 75
					<u>27 01</u>

DATE _____

TOWN OF LEXINGTON — BOARD OF PUBLIC WORKS

WATER DIVISION

Sketch of Service Here

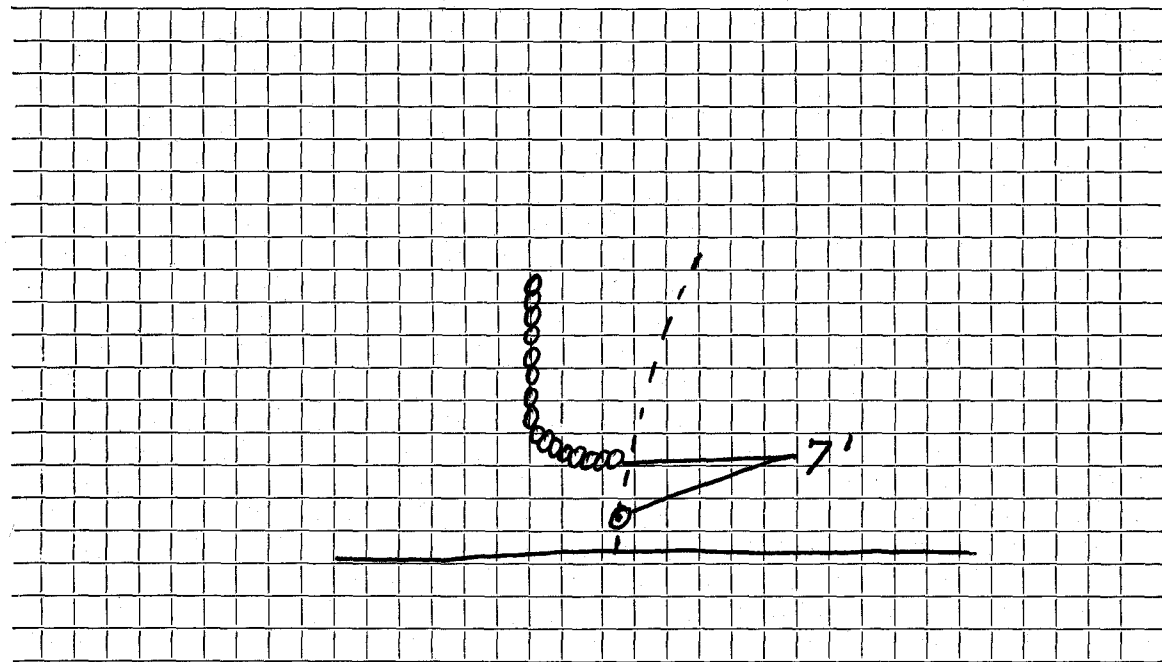

Connection made in Street. Work completed

Remarks:
.....
.....