

WATER SERVICE RECORD

Name

James A. Petersen

Service No.

204

Address

5 Wingate Road

Location

~~Water Service~~ New Service

Service to curb only

Comm 11-30-59


Date	Material	Amount	Total	Date	Amount
9-16-59	Labor	30 03		9-1-59	100 00
	10% O. H.	3 00	33 03	11-30-59	21 99
	60' 3/4" Copper tubing @.11		24 60		Non Charge
	1 3/4" C x 1/2 I.W.H. Stop & Waste	5 88	9/16/55		Labor
	2 Hrs. Town Shovel @6.50	13 00	8'-3/4" Copper tubing @.56		4 48
	2 Hrs. Trucking @.75	1 50	1-3/4" C Corp Cock		4 33
		78 01	1-3/4" C Curb Cock		4 67
			1 Box & Rod		3 90
			1 hr. trucking @.75		75
					19 73
				9-16-59	1 1/2 Straight Tailpiece
					1 1/2 Offset Tailpiece
					50
					50
					20 73

DATE _____

TOWN OF LEXINGTON — BOARD OF PUBLIC WORKS

WATER DIVISION

Sketch of Service Here

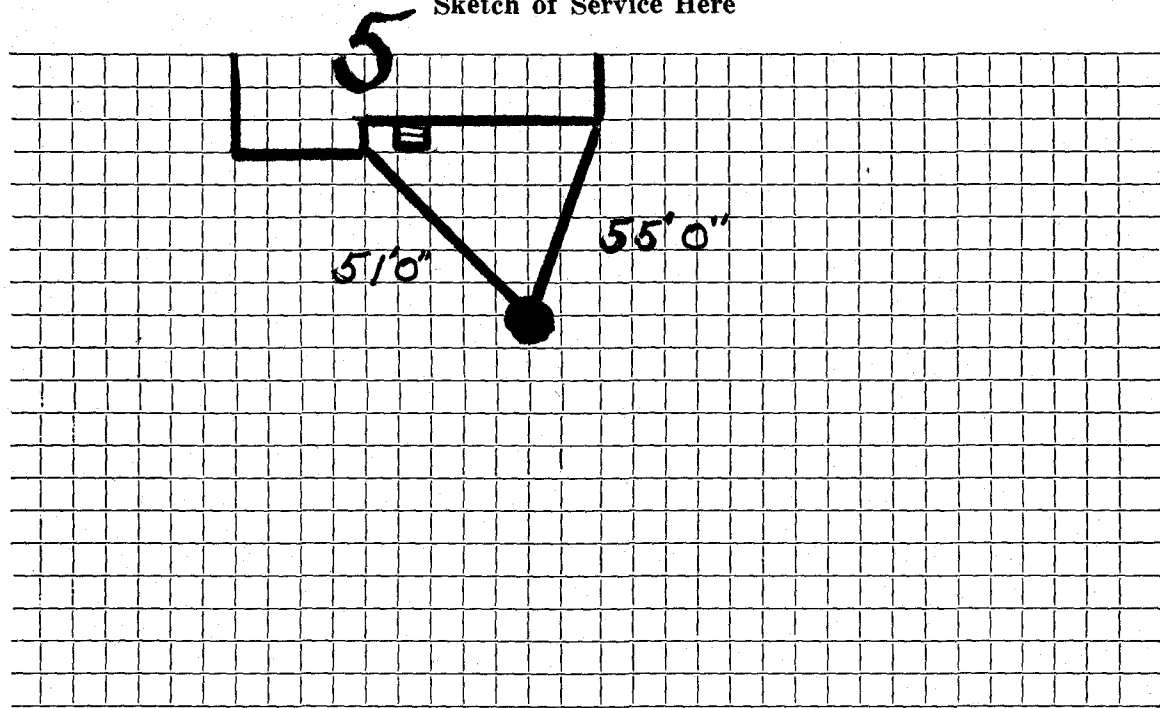

Connection made in Street. Work completed

Remarks:
.....
.....