

WATER SERVICE RECORD

Name

Service No.

Address

6 Wingate Road

Location

~~Repair/ Renewal~~ — New Service

Service curb to main only


Date	Material	Amount	Total	Date	Amount
6-20-56	72' 3/4" COPPER 3/4 x 1/2 I.W.H. S.L.W. 1-3/4 3 PART UNION				
					Non Charge
				9/16/55	Labor 1 60
				21'-3/4"	Copper tubing @.56 11 76
				1-3/4"	C Corp Cock 4 33
				1-3/4"	C Curb Cock 4 67
				1 Box	& Rod 3 90
				1 hr.	trucking @.75 75
					27 01

DATE _____

TOWN OF LEXINGTON — BOARD OF PUBLIC WORKS

WATER DIVISION

Sketch of Service Here

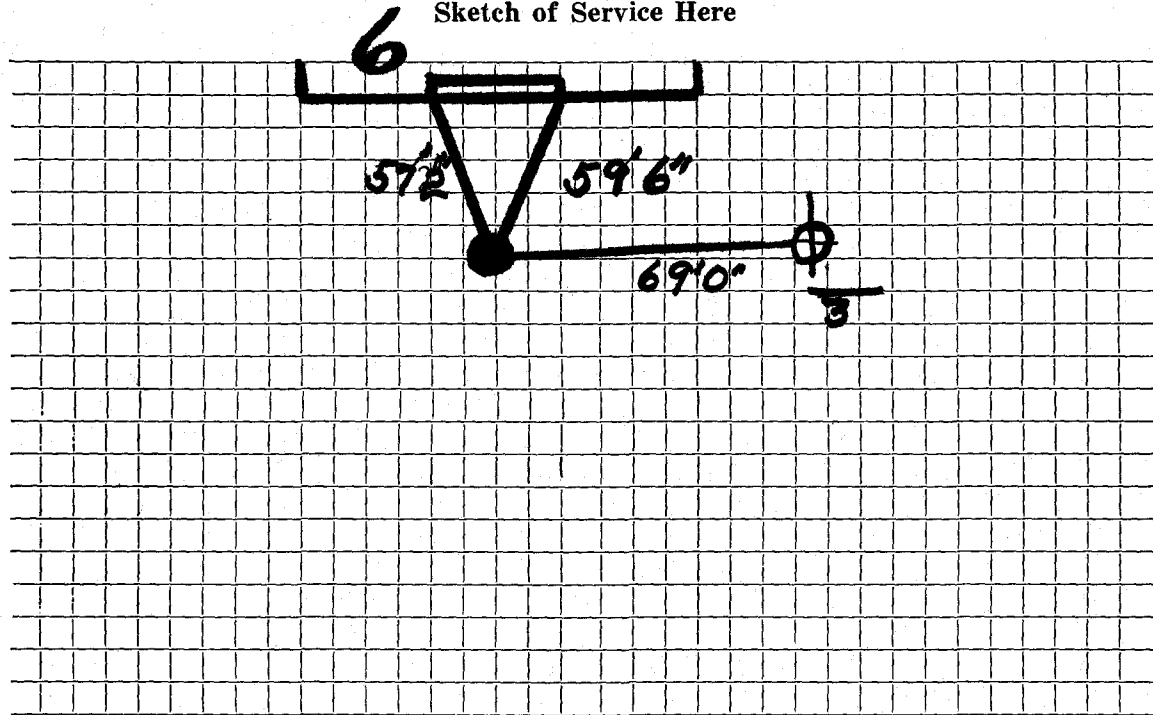

Connection made in Street. Work completed

Remarks:

.....

.....