

WATER SERVICE RECORD

Name A.J. Comeau

Service No. 194

Address 8 Wingate Road

Location

~~Repair~~ ~~Renewal~~ New Service

Comm. 8-15-55

Date	Material	Amount	Total	Date	Amount
7/1/55	Labor	7 57		6-27-55 Deposited	100.00
	10% Overhead	76	8 33	8-15-55 Refunded*	20.82
	70' - 3/4" copper tubing @.3840	26 88		<u>NON CHARGE</u>	
	1 - 3/4C.x1/2" I.W.H.stop&waste	4 00	7/1/55	Labor	7 58
	1 - 3/4C.x3/4"C.Union	1 72	20' - 3/4 copper tubing @.3840		7 68
	5hr. Littlefield Shovel @7.50	37 50	1 - 3/4C. curb-cock		4 33
	1 hr. trucking		1 - 3/4C/x3/4C.curb-cock		4 67
			79 18	1 box and rod	3 90
				1 - 1/2" offset tail piece	50
				1 - 1/2" straight tail piece	50
				1 hr. Littlefield Shovel	7 50
				1 hr. trucking	75
					<u>37 41</u>


* \$4.29 of this refund made payable to town to apply on w.H.C. # 131

DATE _____

TOWN OF LEXINGTON — BOARD OF PUBLIC WORKS

WATER DIVISION

Sketch of Service Here

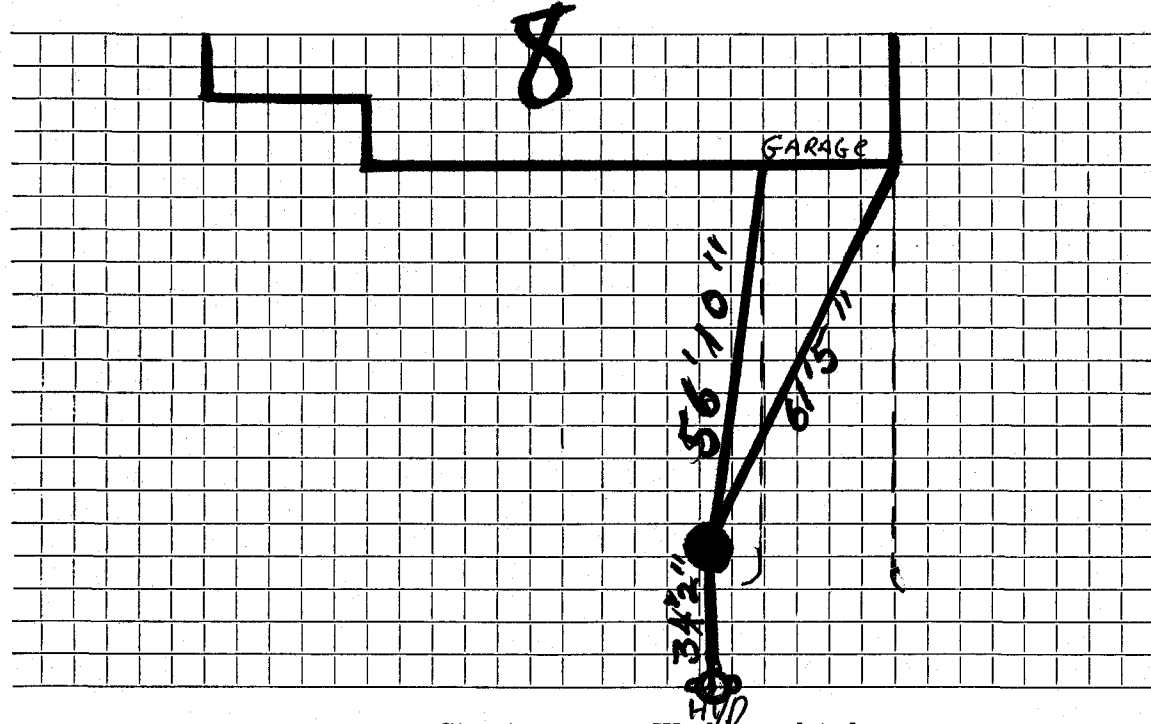

Connection made in Street. Work completed

Remarks:

.....

.....