

WATER SERVICE RECORD

Name Peter Farfaras

Service No. 67

Address 1 Winn Ave.

JUN 20 1977

Location

~~REPAIR WORK~~ - New Service Farfaras & sons #3895


Date	Material	Amount	Total	Date	Amount
4/12/77	labor	6. 30		12/16/76	Deposit 150. 00
	10%OH	. 63	6. 93	6/20/77	<del>Refund</del> 88. 22
25'	3/4 copper @ .65		16. 25		61. 78
1	3/4 corp.		10. 53		
1	3/4 curb.		15. 07		
1	box and rod		13. 00		
			61. 78		
4/13/77	25' - 3/4" COPPER				
				6/20/77	<del>Apply to SHC #107</del> 28. 28
				6/20/77	<del>Apply to SHC #108</del> 5. 89

DATE \_\_\_\_\_

TOWN OF LEXINGTON — BOARD OF PUBLIC WORKS

**WATER DIVISION**

Sketch of Service Here

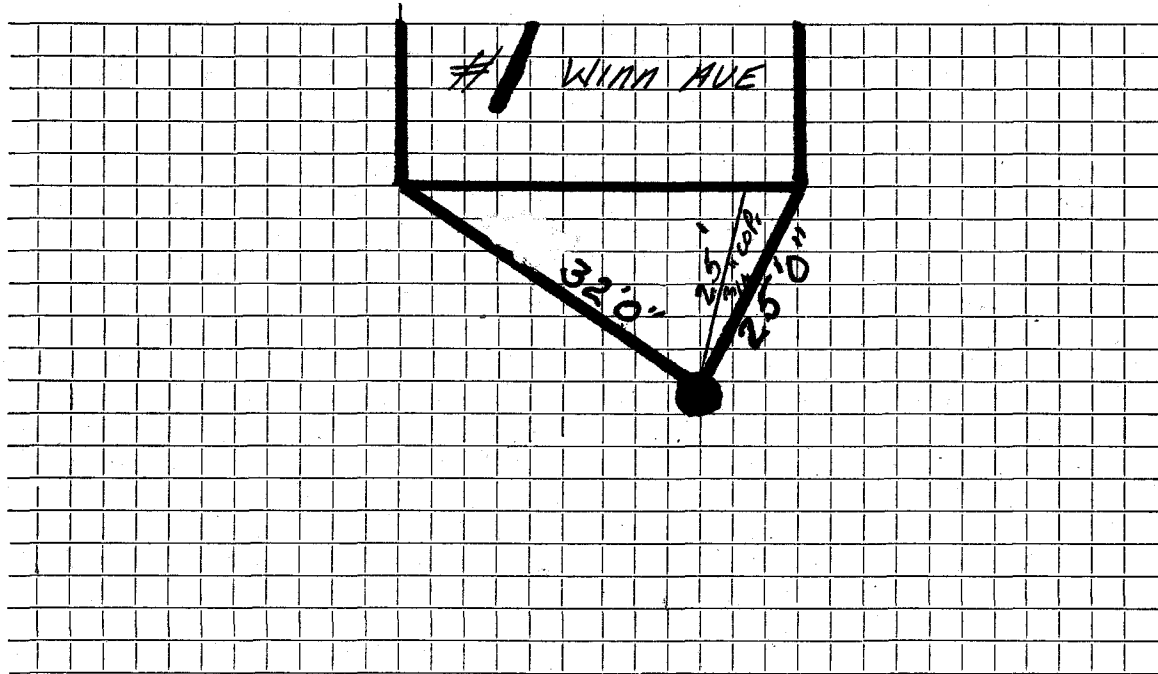

Connection made in ..... Street.      Work completed .....

Remarks: .....  
.....  
.....