

Name Winning Farm

Service No. 19 3082

Address

Location off Lowell Street (*Winning Farm Lane*)

Kind of Pipe

Size

Size of Main

~~Repair~~—Renewal—New Service

Location

Date	Material	Amount	Total	Date	Location	Amount
Nov. 18, '44	Labor	20 80		Nov. 19 '44	<i>Deposited</i>	50 00
	"	7 60	28 40			
	40' - 1" Copper Tubing		9 36		<u>Non Charge</u>	
					4 - 1" C. Corp. Cocks @ 3.65	14 60
			12 24		5' - 2" C. L. Pipe @.45	2 25
			50 00		1 - 1" C x 2" I 4 Way Branch	6 10
					1 2" T. H. Gate Valve	11 55
					1 Box & Rod	1 65
					6' 24" Cement Pipe @1.77	10 62
					1 Sewer M. H. Cover	4 15
					Trucking 2 hrs. @.75	1 50
					Patching	4 00
	Labor					56 42

DATE _____

TOWN OF LEXINGTON—BOARD OF PUBLIC WORKS

WATER DIVISION

The undersigned applies for a supply of water at No. _____ St. and hereby agrees to comply with the rules and regulations as now, or at any future time, established by the Board of Selectmen.

Am't. of Estimate \$ _____


Owner _____

Am't. Paid \$ _____

Address _____

Builder _____

Sketch of Service Here

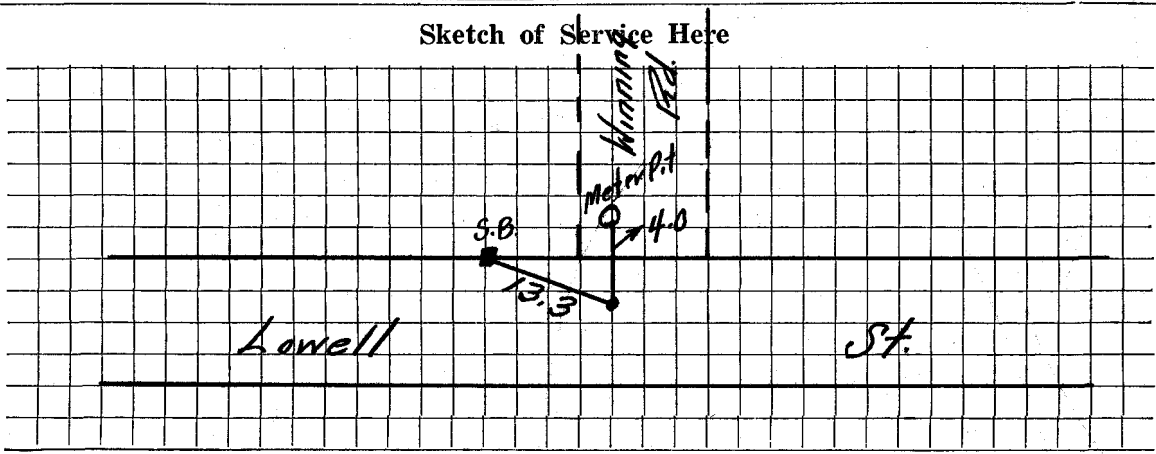

Connection made in _____ Street.

Work completed _____ 19

Remarks: